
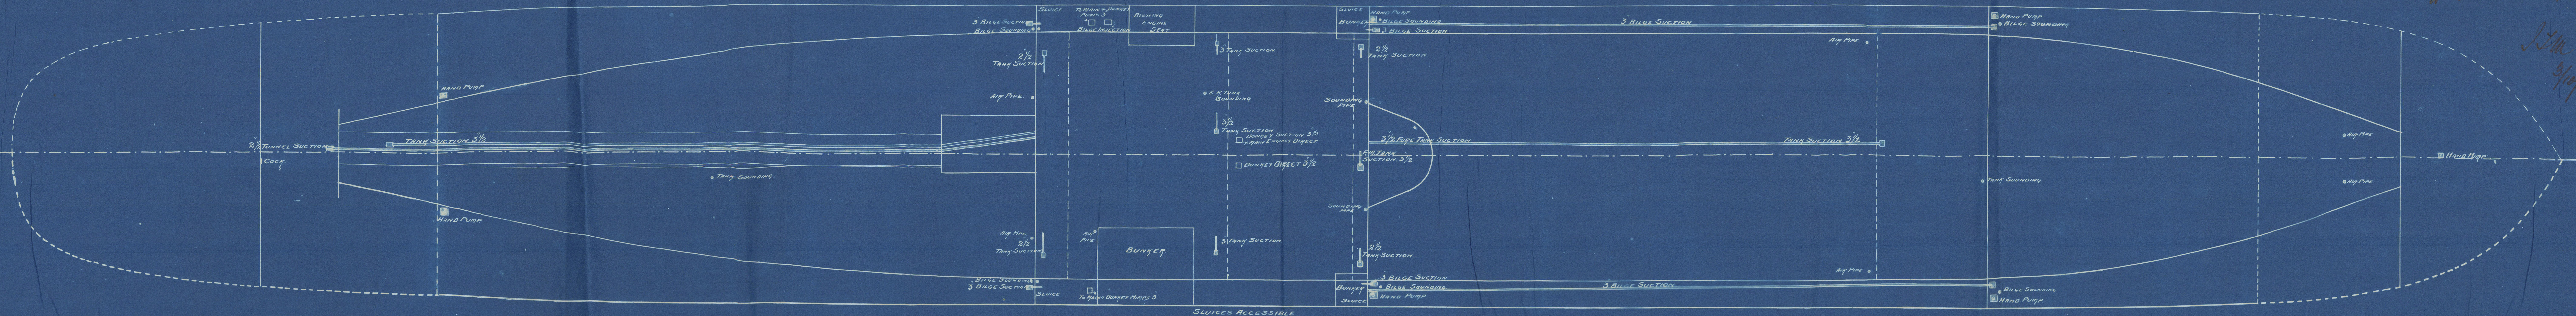


—PUMPING ARRANGEMENT,—

—N° 416.—

DISPLACEMENT ABOUT 2650
SCALE 1/8" = 1 FOOT

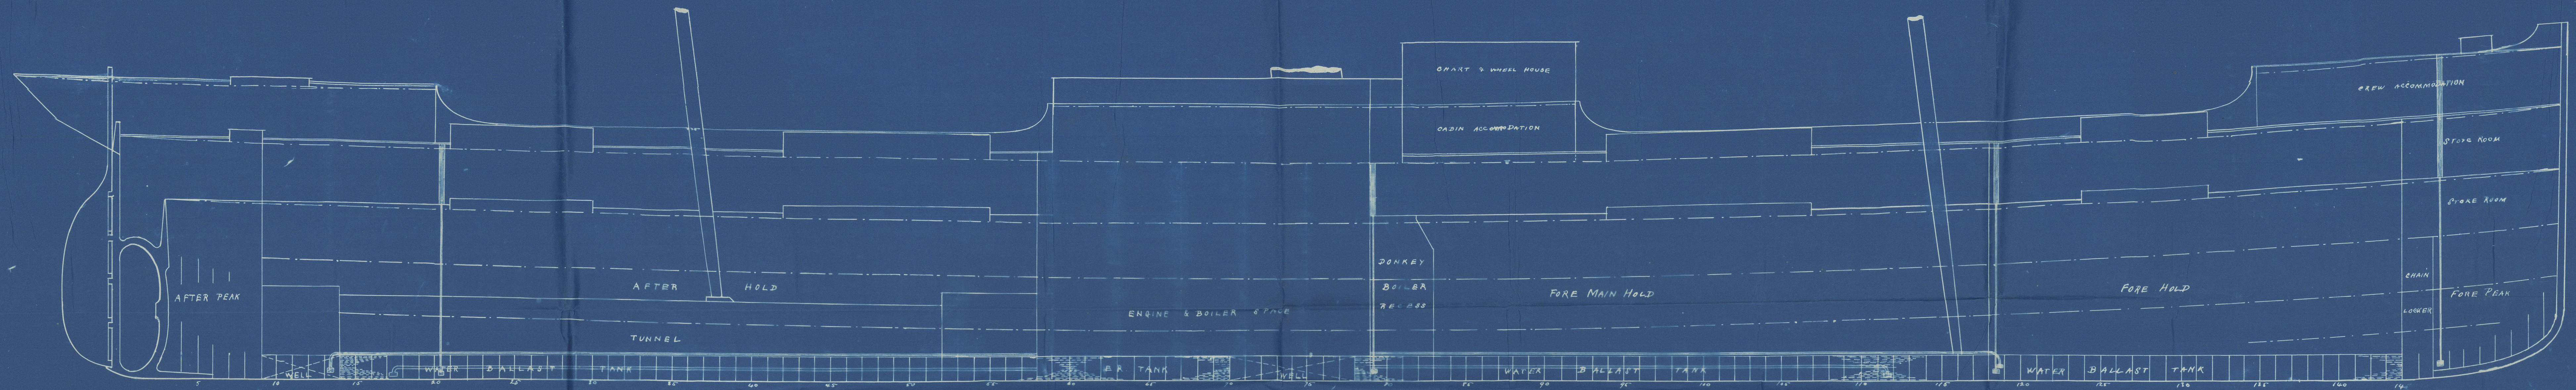

Left hand pumps set to forward shift

3/10/95



3/10/95




Sir Raylton Dixon & Co

N^o 416

Pumping Arrangements

W. D. Baird Lang

Intro report no 1668

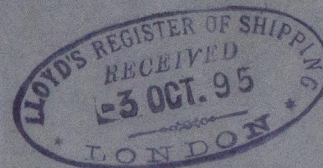

MDB 753 - 0145



© 2020

Lloyd's Register
Foundation