

s/o Kinghor

Received at Middlesboro Office, 9th Dec. 1895

Lloyd's Register of British and Foreign Shipping.

Middlesboro (Report on Vessel No. 1412 Port Mbro)

No. 3143. a. SHIP FORGINGS OR CASTINGS.

I have to report that the undermentioned Iron or Steel Forgings or Castings,
 manufactured by the Stokton Forge Co.

of Stokton for the Vessel No. 314, being built
 by Messrs Roper & Son of Stokton

have been inspected by me as set forth below, and found to be, so far as can be seen,
sound

Mark on Forgings.

Lloyd's

No. 3143 a
No. 6.



Hugh Cameron

Sunderland

4-12-95.

	STERN FRAME.	RUDDER FRAME.	STEM.
Material*	Scrap iron	Scrap iron	Scrap iron
How made	Forged	Forged	Forged
Dimensions	11' 6"	8' 11"	11' x 2 3/8
Progress on Inspection	Forged & milled	Forged & milled	Forged
Date when Inspected	Sept 23 ^d to Nov 6/95	Nov 18 th to 28/95	Oct 7/95

SKETCHES OF FRAMES SHOWING POSITION AND DESCRIPTION OF WELDS OF FORGINGS, OR PARTICULARS OF
 TESTS APPLIED TO CASTINGS.

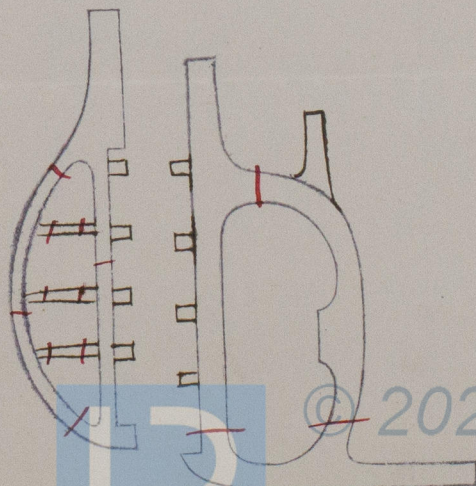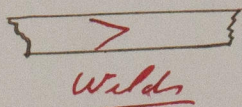

Fee (if any chargeable) £ : :

To be paid at

* If of Iron, state whether scrap or puddled Iron.

© 2020

Lloyd's Register
Foundation

MD5753-0262