

# LLOYDS DIMENSIONS

LENGTH FROM AFTER PART OF STEM TO FORE PART OF STERN POST	308.2
BREADTH MOULDED	43.0
DEPTH TO SKIN ASSUMING 11 ROUNDOF BEAM	23.11

PROPORTIONS

12.88 DEPTHS IN LENGTH	12 TO 13
7.63 BREADTHS	

# MIDSHIP SECTION

SCALE 1/2 INCH TO A FOOT

DIMENSIONS


310.0 BP x 44.0 EXT x 23.0 MOULDED

TO CLASS 100A1 AT LLOYDS TWO DECK RULE

## EQUIPMENT

TWO STOCKLESS BOWERS	12.2.0
ONE DO DO DO	26.1.0
ONE STREAM ANCHOR EX STOCK	10.3.0
ONE KEDGE	5.2.0
240 FATHOMS OF 1 1/2" STUD CHAIN CABLE	
75 DO DO DO	1 1/2" STREAM CHAIN OR 4 1/4" STEEL WIRE
100 DO DO DO	1 1/2" HEMP TOWLINE OR 4" DO
90 DO DO DO	9/16" HAWSER OR 3/4" DO
90 DO DO DO	8" WARP OR 2 3/8" DO

SCANTLING NUMERAL	NUMERALS	EQUIPMENT NUMERAL
HALF GIRTH 41.75		PCBLE 34.16
BEAM 21.90		BRIDGE 60.00
DEPTH 23.91		POOP 32.04
	87.56 x 308.16 = 26882	12.6.16 26882 = 1379 PCBLE = 28861
	88 26600	3.8.16 8 = 21.19 FOR EQUIPMENT 30020
	91 28700	

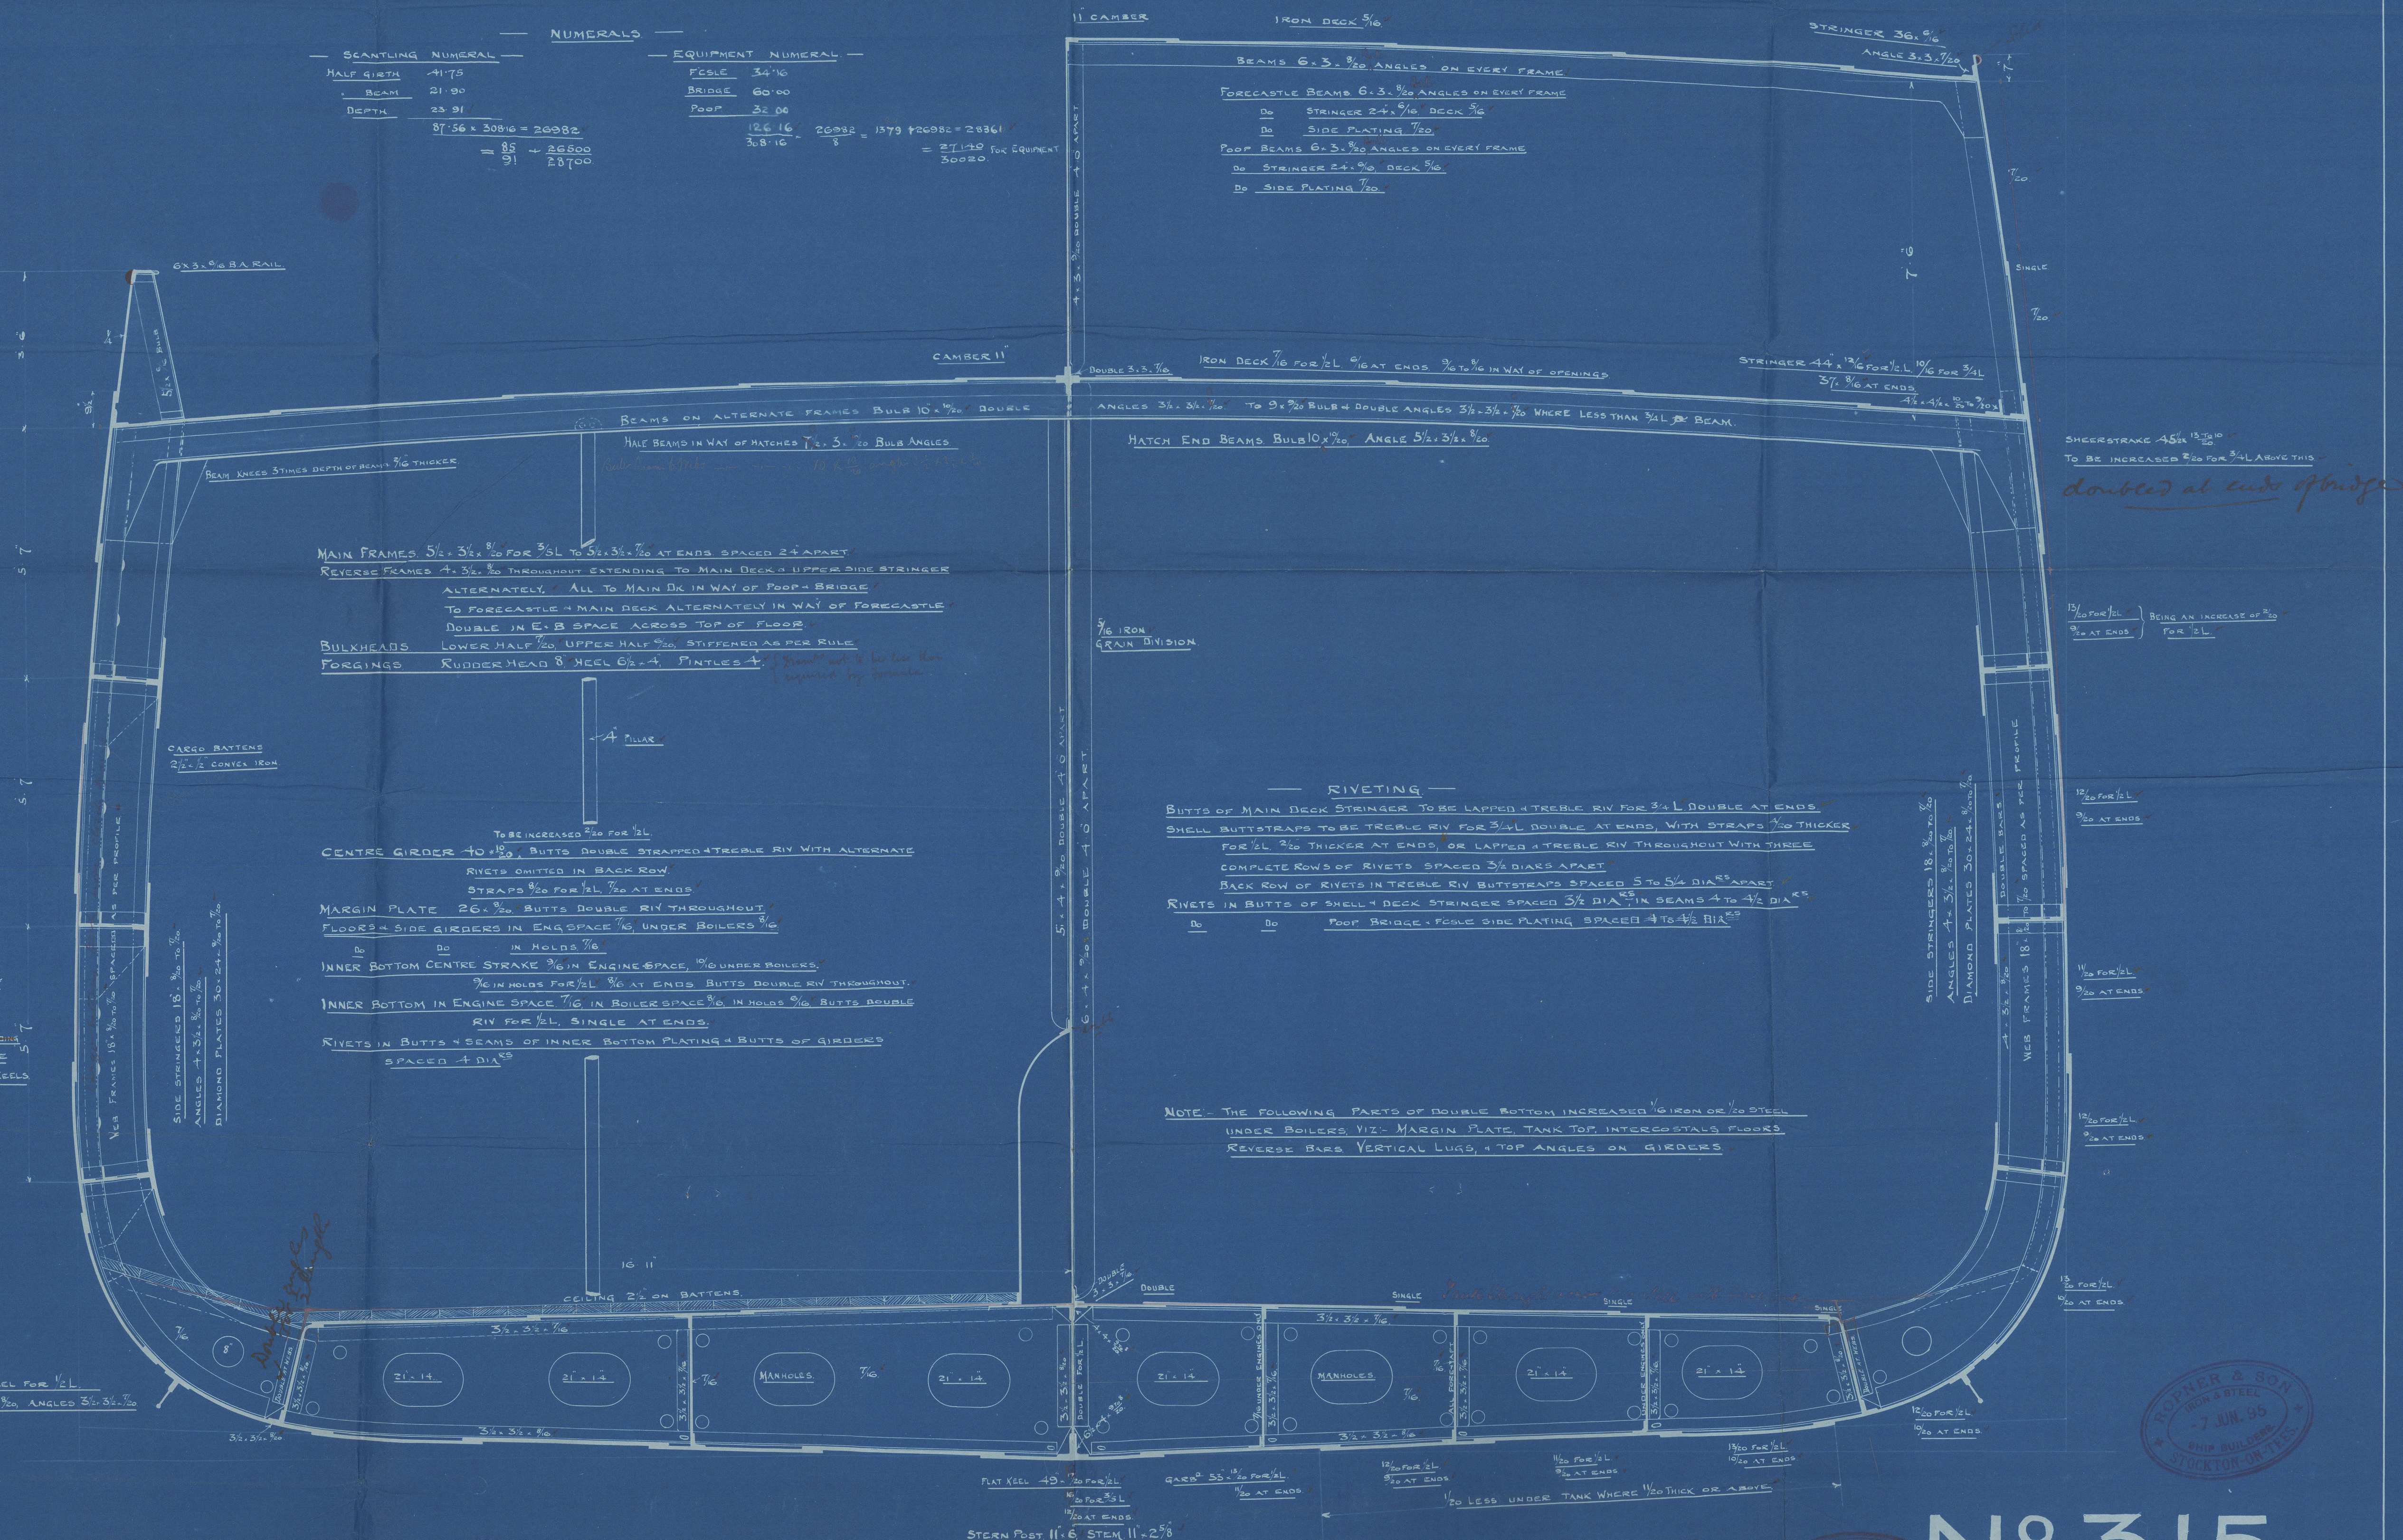

ROPER & SON  
7 JUN 05  
SHIP BUILDERS  
STOCKTON-ON-TES

ROYAL EXCHANGE  
MIDLANDS & NORTH  
SHIPPING

Nº 315



Friendship Section  
Roper Hon

No 315.


Renumbered 314.

P. S. "Kingston"

Intro Report - No 1414



MDB 758-0267

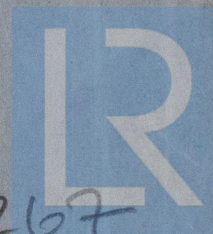

© 2020

Lloyd's Register  
Foundation