

Marine Engineer 16th 1253

Apr 20th 9. 9. 95
19. 1. 46


CLARK & COY. LTD.
ENGINEERS
21, 23 & 25
MARKET STREET
STOCKTON-ON-TEES

TANK PIPE PLAN

DIMENSIONS 310.0 x 44.0 x 23.0 MLD

SCALE 1/8" TO A FOOT

APPROX. UNDER-DECK TONNAGE 2380

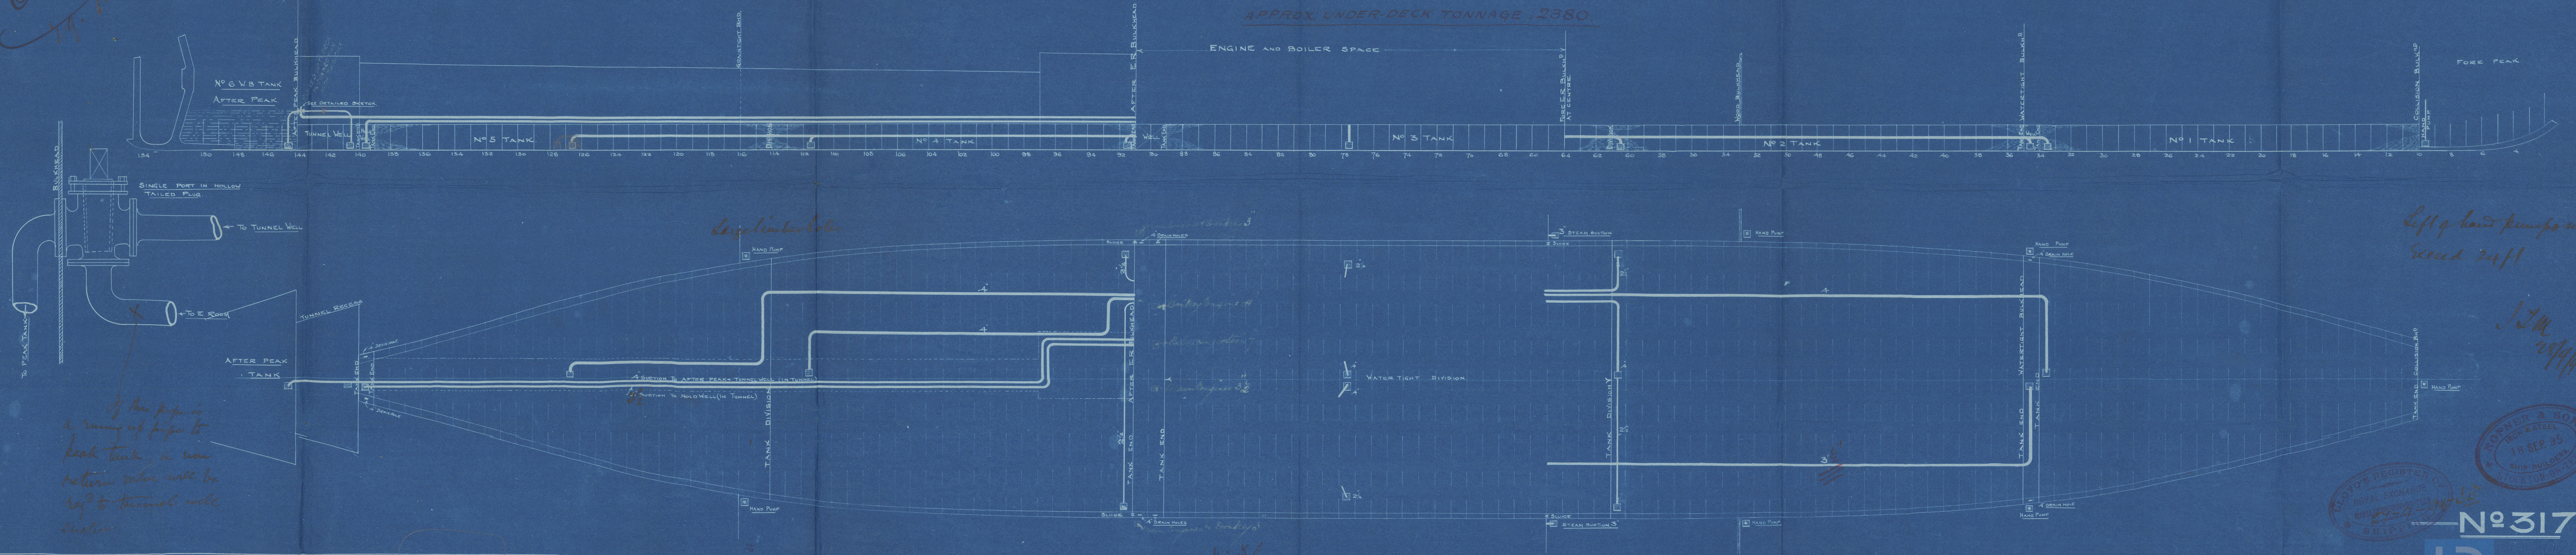

If this pipe is a run up pipe to peak tank, a non return valve will be req^d to tunnel well suction

Left hand pumps not to exceed 24 ft

J.M.
28/9/95

W.H.
24/9/95

Pumps accessible if fitted


ROYAL EXCHANGE
SHIP BUILDERS
STOCKTON-ON-TEES

ROPER & SON
IRON & STEEL
18 SEP 95
SHIP BUILDERS
STOCKTON-ON-TEES

No 317

Lloyd's Register

DB 753-0269

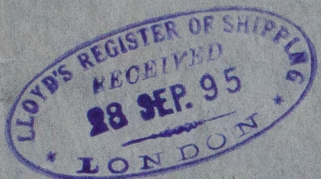

Pumping Plan
Roper & Son's

No 314

S.S. "Mingtor"

Intro Report - No 1717



MDR 753-0269



© 2020

Lloyd's Register
Foundation