


Length front of stem to fore part of stump or ... 312' 2"
 Breadth in mouth ... 13 9' 2"
 Depth with 11' round of beam ... 24' 2"
 Depth in length = 12 to 13
 Breadth in length

9. 12. 95
16. 3. 96

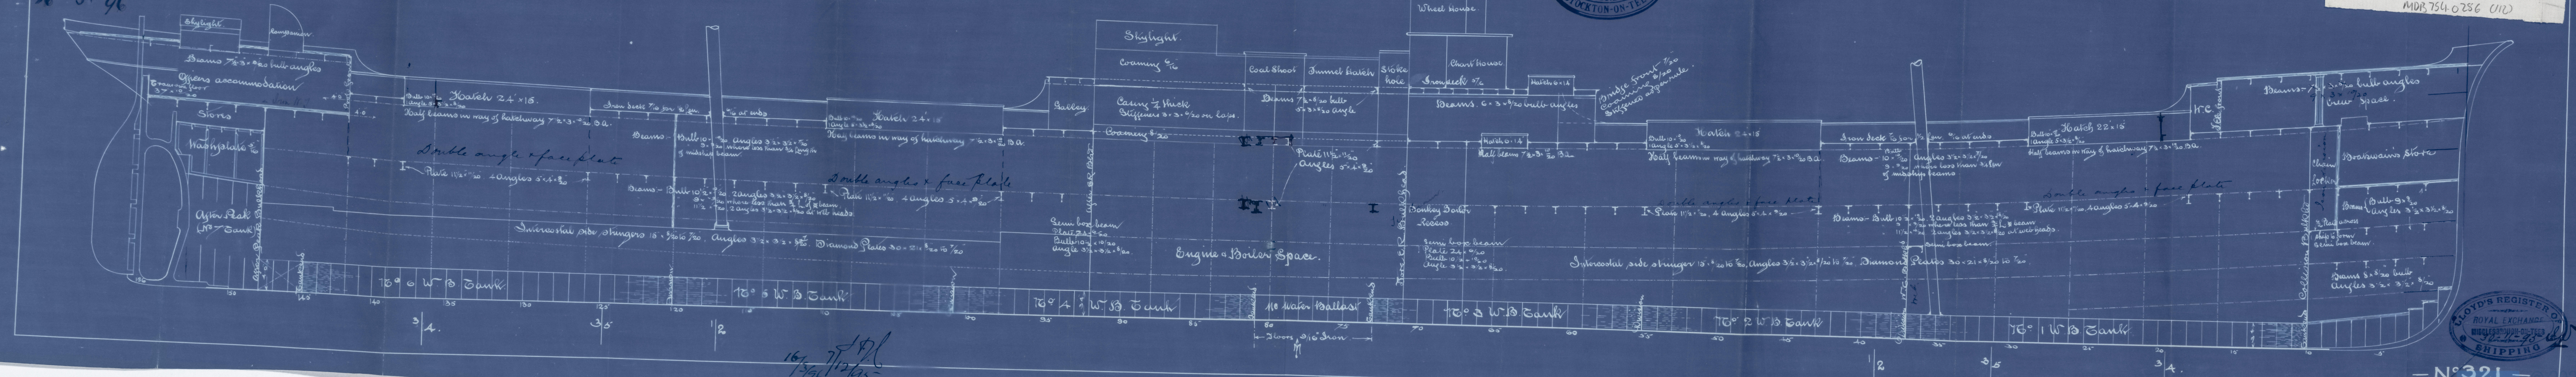

16/3/96 J.F.L.
7/12/95

ELEVATION
DIMENSIONS - 31'4" x 44" x 23'3" M-L
SCALE 1" = 1 FOOT
Go class at Plybo "100A1" Steel Three Deck (with freebo)



MIDDLEBROUGH ON TREES.
Sent with Greenbush Report
Please return when done with
MDR 754.0286 (112)



— №321.

4 No: 325 appo. 16/3/96

11) B 784 - 0286 (2 n)

Lloyd's Register
Foundation

Profile.
Ropner Bros
No 321 & No. 325

S.S. "Iva"

Abro Report No 1480

S.S. "ÆON" (No 325)

Abro Report No 1842

MDB754-6296



© 2021

Lloyd's Register
Foundation