

Ys 'AEON'

Received at *Middlesbrough* Office, *6<sup>th</sup> July* 189*6*

## Lloyd's Register of British and Foreign Shipping.

*Middlesbrough* (Report on Vessel No. *1842* Port *India*)No. *3275 a*. SHIP FORGINGS OR CASTINGS.

I have to report that the undermentioned Iron ~~or Steel~~ Forgings ~~or Castings~~,  
 manufactured by *The Stockton Forge Co.*

of *Stockton* for the Vessel No. *325*, being built  
 by *Messrs Ropner & Son* of *Stockton*

have been inspected by me as set forth below, and found to be, so far as can be seen,  
*Sound*

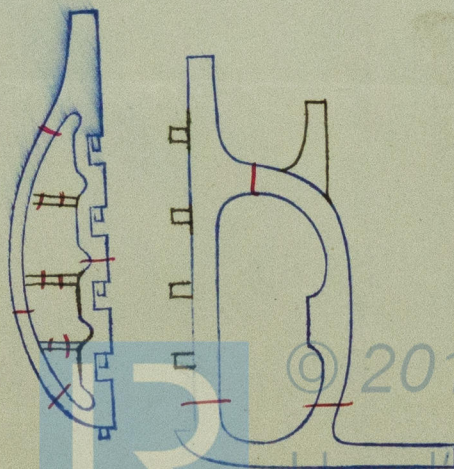
Mark on Forgings.

Lloyd's

No. *3275 a*  
*No. 6**Wm Cameron**Sunderland*

	STERN FRAME.	RUDDER FRAME.	STEM.
Material* ...	<i>Scrap iron</i>	<i>Scrap iron</i>	<i>Scrap iron</i>
How made ...	<i>Forged</i>	<i>Forged</i>	<i>Forged</i>
Dimensions ...	<i>11' x 5' 7/8</i>	<i>8' - 4"</i>	<i>11' x 2 1/2</i>
Progress on Inspection	<i>Forged &amp; smithed</i>	<i>Forged &amp; smithed</i>	<i>Forged</i>
Date when Inspected	<i>March 13<sup>th</sup> to April 30/96</i>	<i>May 11<sup>th</sup> to July 2/96</i>	<i>April 30/96</i>

SKETCHES OF FRAMES SHOWING POSITION AND DESCRIPTION OF WELDS OF FORGINGS, OR PARTICULARS OF  
 TESTS APPLIED TO CASTINGS.

*Welds*

Fee (if any chargeable) £

To be paid at