

STEEL BOILER

SCALE 1" = 1 FOOT



WP 90 LBS^a (LLOYDS)

FOR MESSRS RICHARDSON, DUCK, & CO N^o ~~456~~ S.S

ORDER N° ~~914~~ 1018.

HEATING SURFACE 480^{sq}

GRATE AREA 22^{sq}

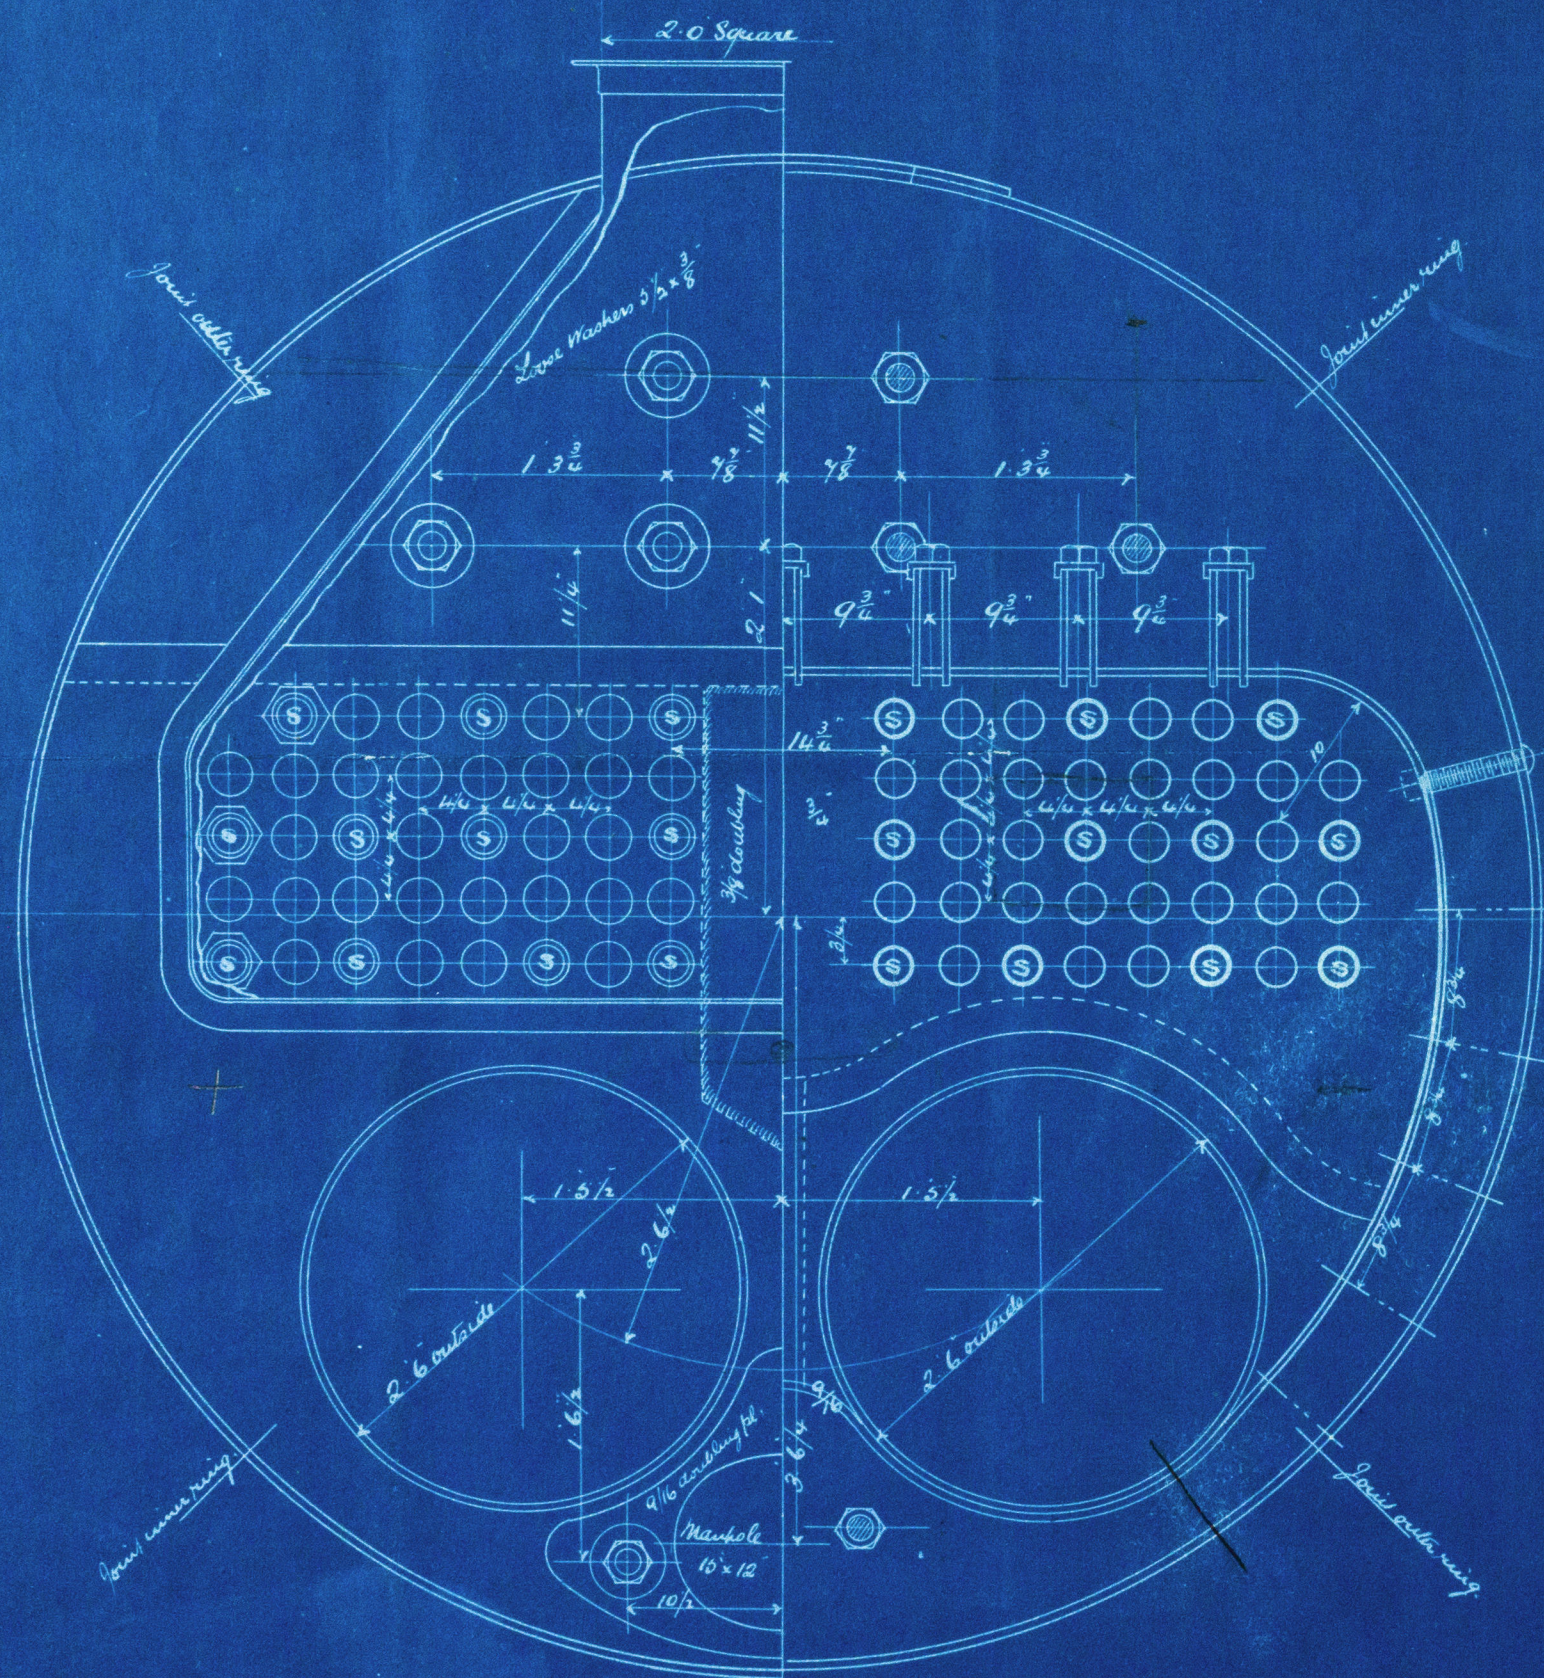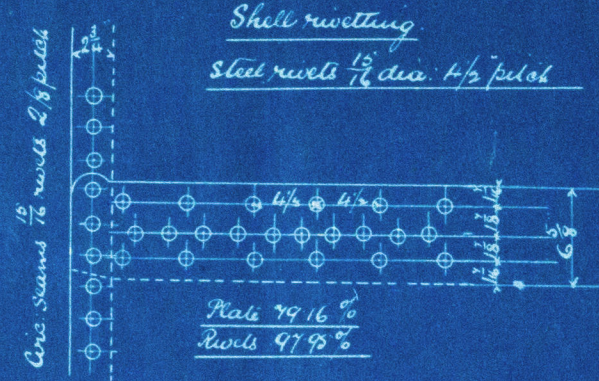

6/7/95.

THOS SUDRON & CO LTD
IMPERIAL BOILER WORKS
STOCKTON-ON-TEES