



REGISTERED
7.8.96
LONDON

PUMPING ARRANGEMENT

Nº 121

1/4" SCALE

Under BK Damage 195 2m

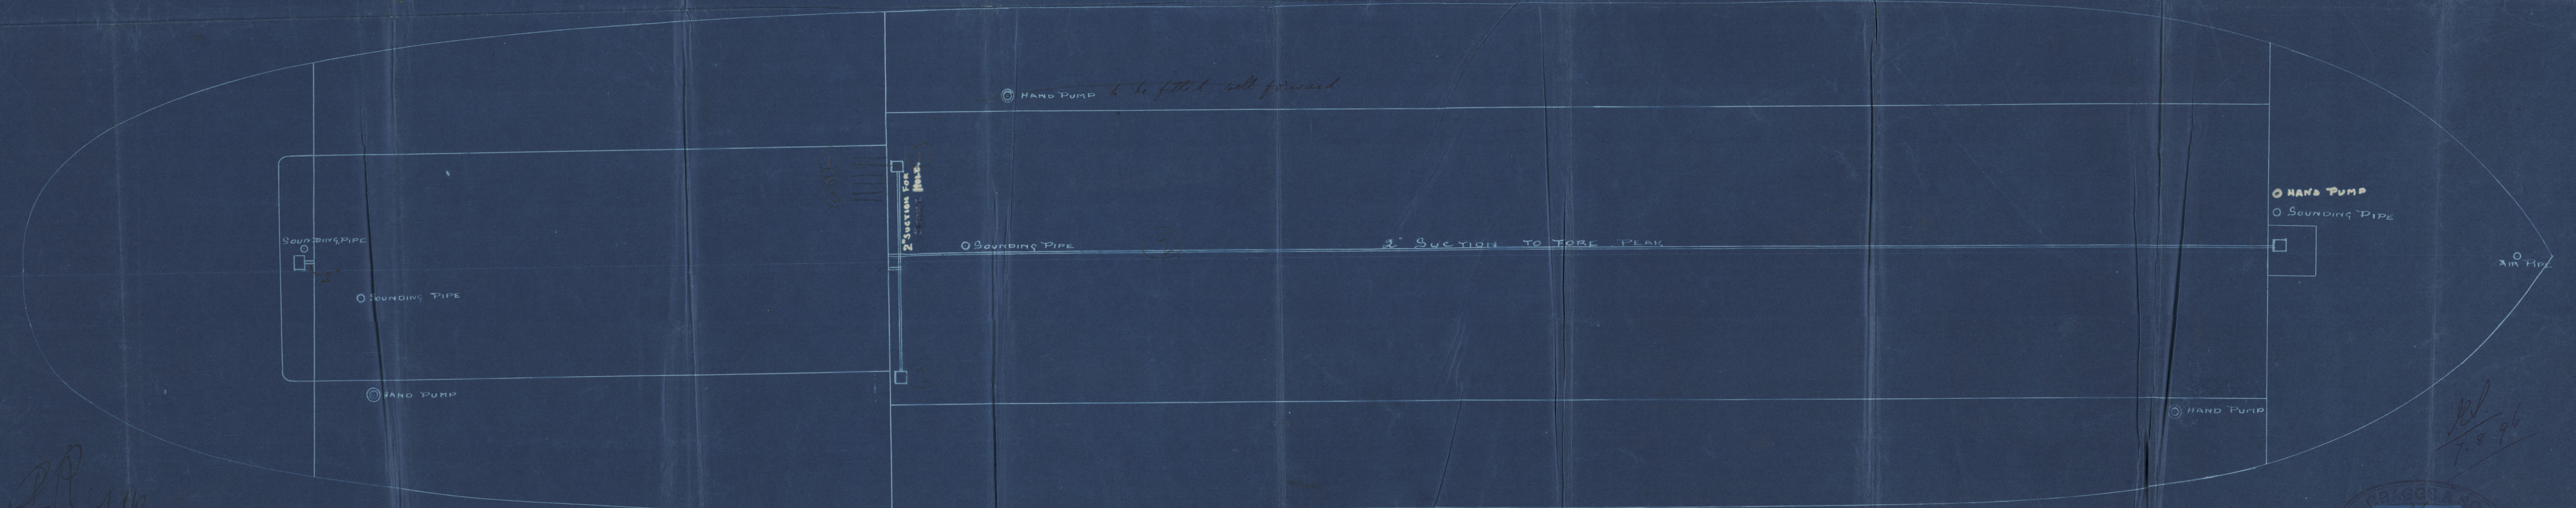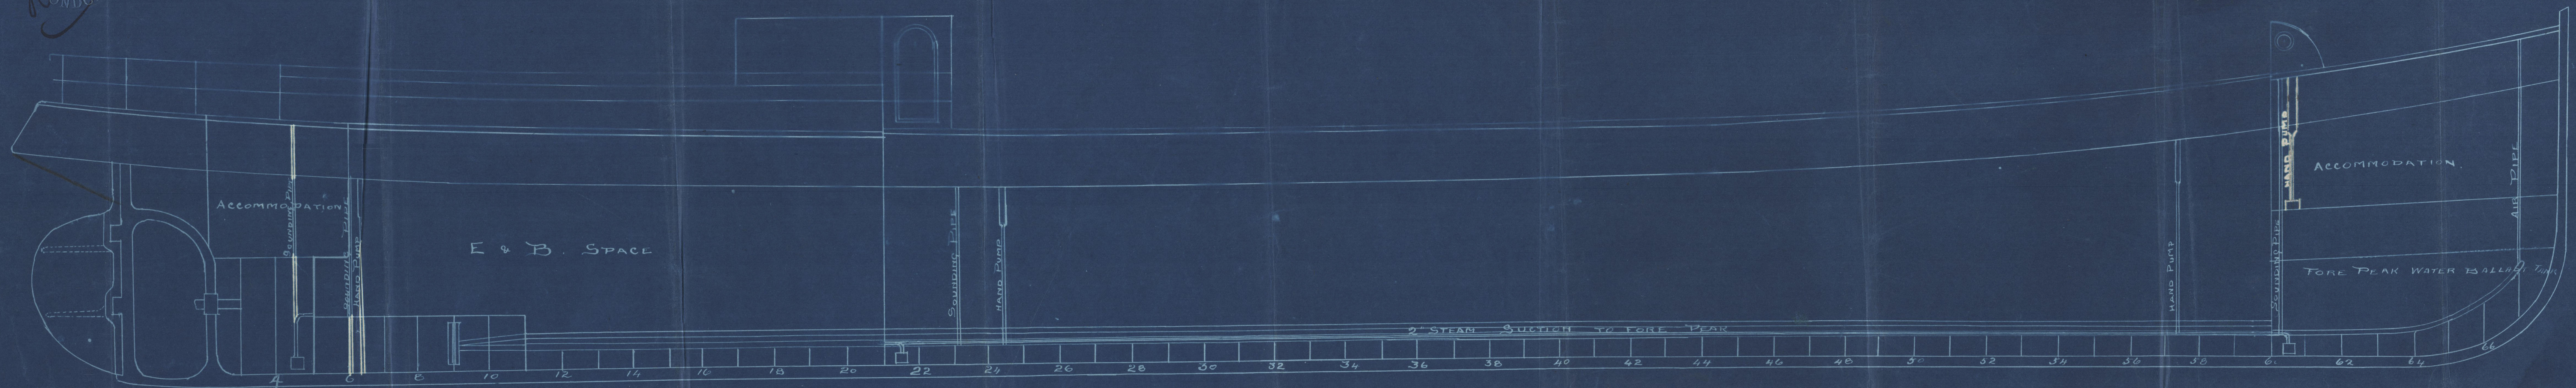

RR
11/10

RR
7.8.96

REGISTERED
7.8.96
LONDON

R. Cragg & Sons

No. 121

Pumping Arrangements

^uReady S.S.

Mde Report - No 1895



MDB755-0142



© 2020

Lloyd's Register
Foundation