

1/2 Ready

Received at *Middlesbrough* Office, *28th Dec* 1896

# Lloyd's Register of British and Foreign Shipping

Inch (Report on Vessel No. *1895* Port *NEWCASTLE ON TYNE*)

No. *5337*

## SHIP FORGINGS OR CASTINGS.

I have to report that the undermentioned Iron ~~or Steel~~ Forgings ~~or Castings~~,  
 manufactured by *Messrs Emerson Walker & Thompson*  
 of *Dunston* for the Vessel No. *121*, being built  
 by *Messrs R Briggs & Sons* of *Middlesbrough*  
 have been inspected by me as set forth below, and found to be, so far as can be seen,  
*sound*

Mark on Forgings.

Lloyd's

No. *57588*

*JG*


*John C Craig*

*Newcastle*

*26-10-96*

	STERN FRAME.	RUDDER FRAME.	STEM.
Material*	<i>Scrap Iron</i>	<i>Scrap Iron</i>	
How made	<i>Forged</i>	<i>Forged</i>	
Dimensions	<i>6 - 2 1/2</i>	<i>3 3/4 - 2 1/4</i>	
Progress on Inspection	<i>Finished</i>	<i>Finished</i>	
Date when Inspected	<i>May 29/26</i>	<i>September 18/26</i>	

SKETCHES OF FRAMES SHOWING POSITION AND DESCRIPTION OF WELDS OF FORGINGS, OR PARTICULARS OF TESTS APPLIED TO CASTINGS.

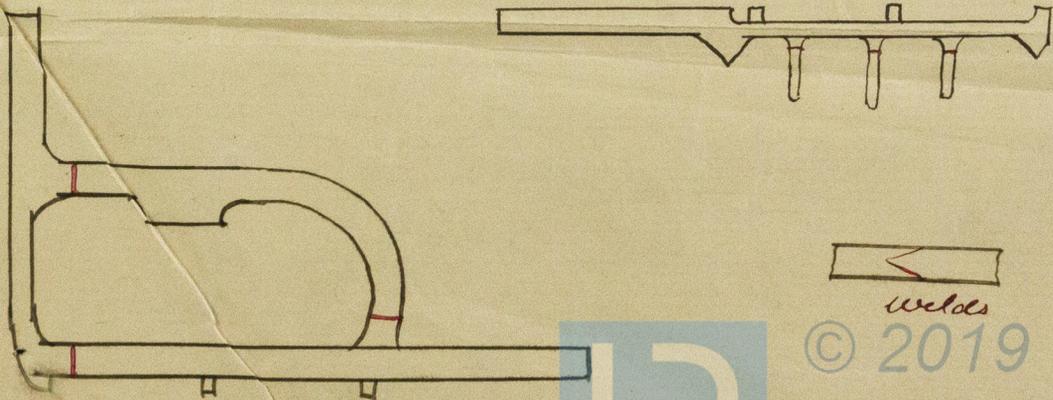

© 2019

Lloyd's Register Foundation