


S. S. Nos 428-9

SCALE 74 INCH = 1 FOOT.

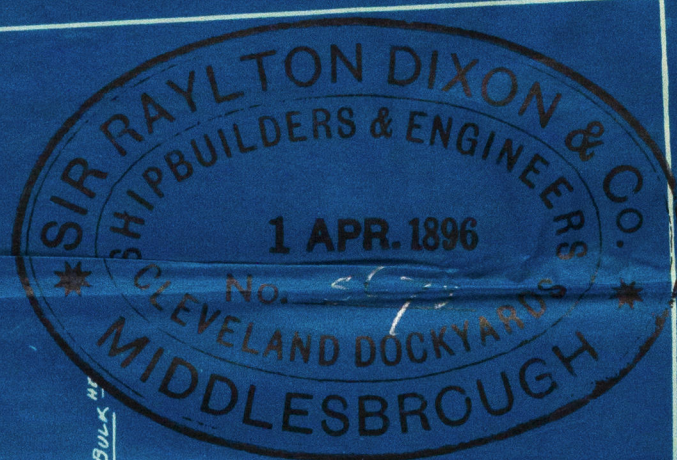


FLOOR 7/20

FLOORS 9/20

FLOORS 7/20

ALL ANGLES UNDER BOILERS INCREASED $\frac{1}{20}$

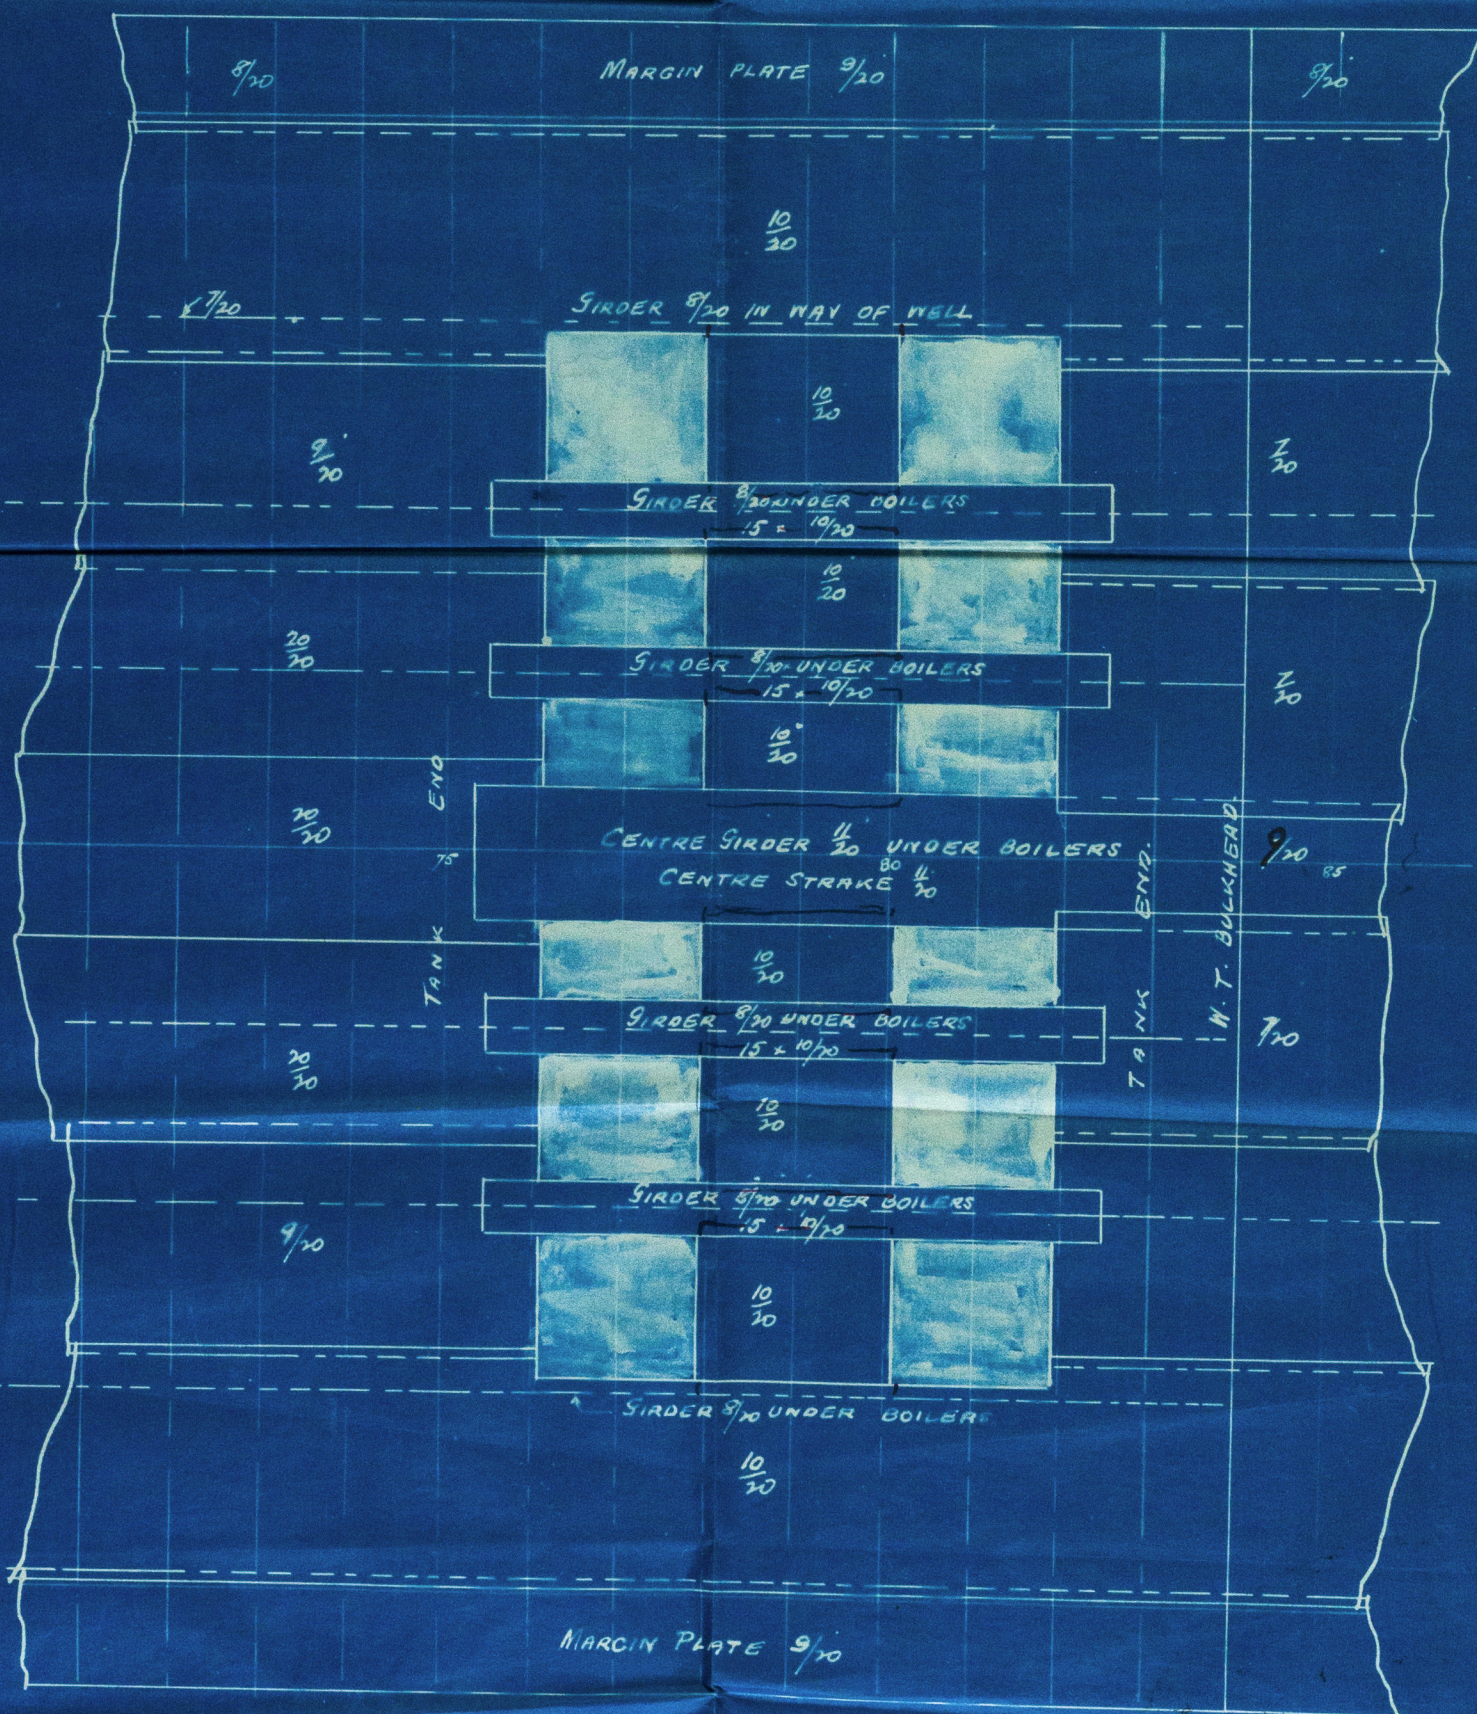

9/9/96

MARCH 28/3/94

1

MIDDLESBROUGH-ON-TEES

To be returned for guidance in
the survey of sister vessels

MDB755-0157 (1/2)

Sir Raylton Dixon & Co.

N^o 428.9

Inner Bottom under Boilers

N^o 428.

"Oceano" S.S.

Middle Repair - N^o 1899

N^o 429. "Melocoris" Middle Repair - N^o 1937



MDB755-0157 (2/2)



© 2020

Lloyd's Register
Foundation