


6.5.96  
REGISTER OF  
SHIPS  
LONDON

# - PUMPING ARRANGEMENT -

UNDER DECK TONNAGE ABOUT 2470

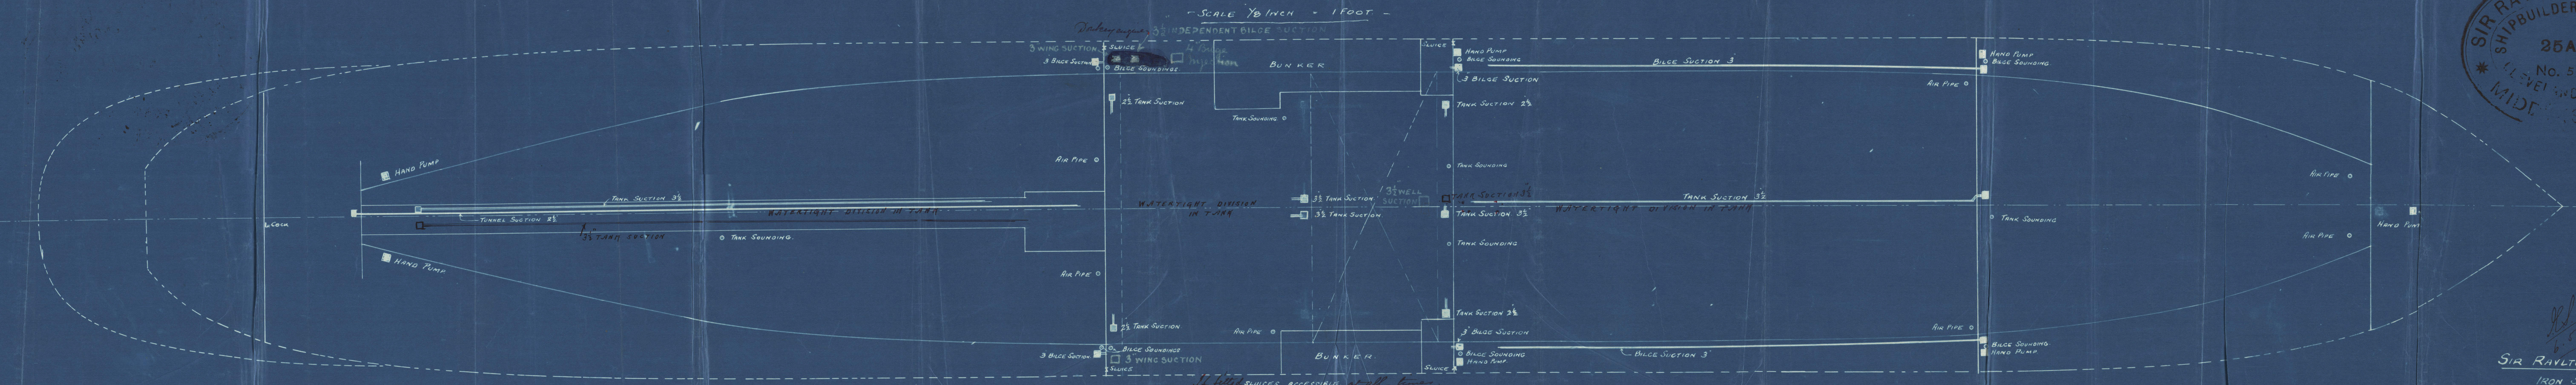

Nos 428-9-

SIR RAYLTON DIXON & CO.  
SHIPBUILDERS & ENGINEERS  
25 APR. 1896  
No. 5732  
CLEVELAND DOCKYARD  
MIDDLESBROUGH

SIR RAYLTON DIXON & CO.  
IRON SHIPBUILDERS  
CLEVELAND DOCKYARD  
MIDDLESBROUGH





Sir Raylton Dixon & Co.

Nº 428 + 9.

Pumping Arrangements.

Nº 428.

"Oceanos, S.S."

Mech. Report Nº 1899

Nº 429 "Mitoeris" Mech. Report Nº 1937

