
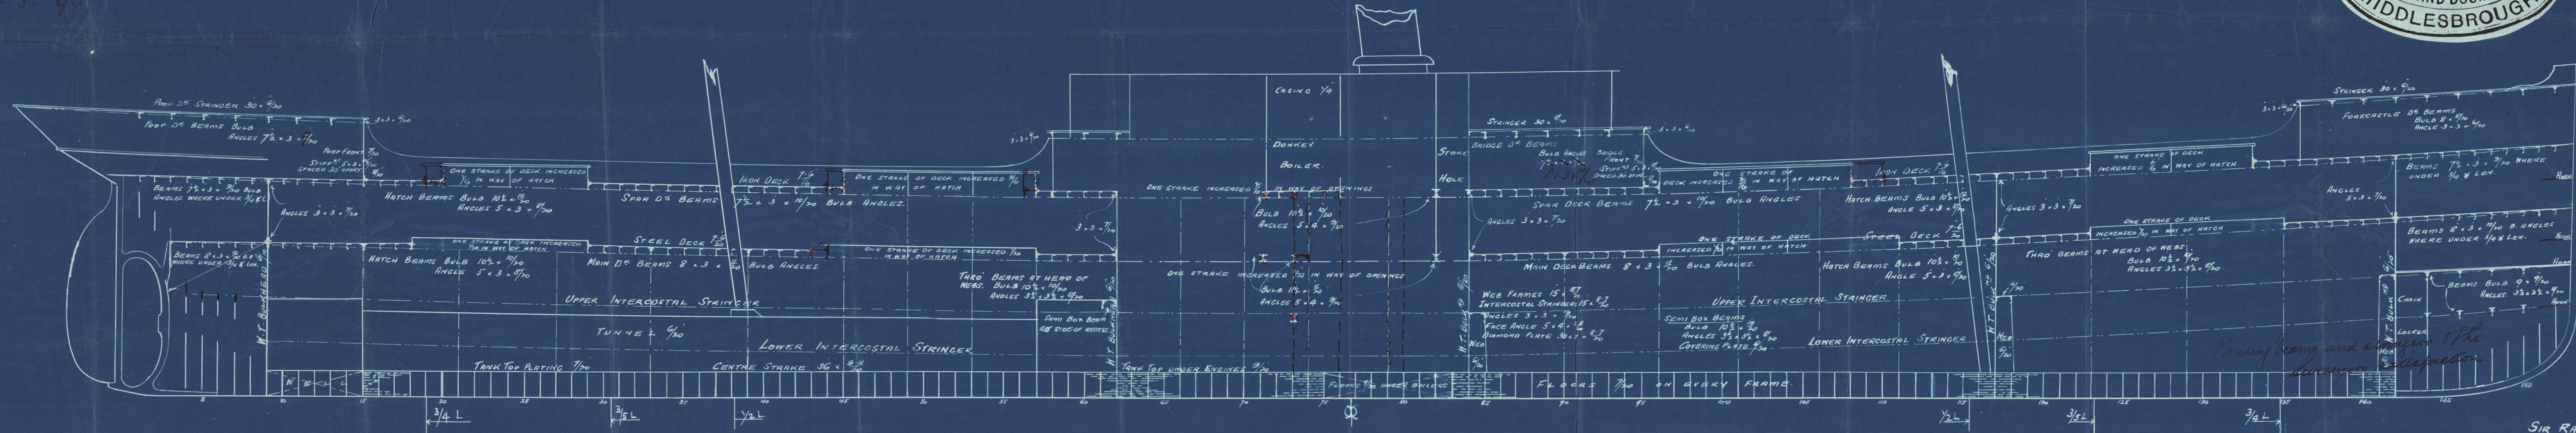


PROFILE

308.0 x 43.2 x 25.0 1/2

SCALE 1/8" = 1 FOOT

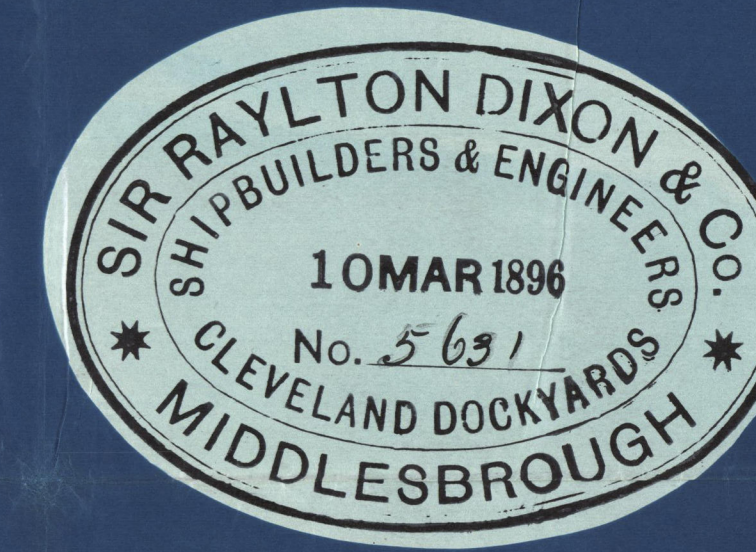

N° 428

* No. 429
appo. 21.3.96

13/3/96

SIR RAYLTON DIXON & CO
IRON SHIPBUILDERS
CLEVELAND DOCKYARDS
MIDDLESBROUGH ON TEES.



Air Raylton Diton & Co.

N^o 428 & 429


Profil.

N^o 428.

"
Oceano S.S.

Made Report N^o 1899

N^o 429. "Mitocris". Made Report N^o 1937

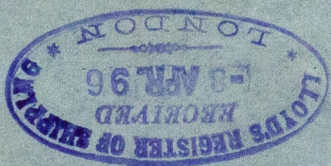

MDB755 - 0159(2/2)



© 2020

Lloyd's Register
Foundation

MDB755 - 0159(1/2)

MIDDLESBROUGH-ON-TEES.

To be returned for guidance in
the survey of sister vessel