

Received at Middlesbrough Office, 6th July 1896

Lloyd's Register of British and Foreign Shipping.

(Report on Vessel No. Middlesbrough Port Middlesbrough)

No. 3282 a SHIP FORGINGS OR CASTINGS.

I have to report that the undermentioned Iron or ~~Steel~~ Forgings or Castings, manufactured by The Sunderland Forge Co. of Pallion for the Vessel No. 428, being built by Wm. R. Dixon & Co. of Middlesbrough have been inspected by me as set forth below, and found to be, so far as can be seen, sound

Mark on Forgings.

Lloyd's

No. 3282 a

No. 6


Wm. R. Dixon
Sunderland

| | STERN FRAME. | RUDDER FRAME. | STEM. |
|------------------------|--|---|------------------------|
| Material* | <u>Scrap iron</u> | <u>Scrap iron</u> | <u>Scrap iron</u> |
| How made | <u>Forged</u> | <u>Forged</u> | <u>Forged</u> |
| Dimensions | <u>10' x 6'</u> | <u>8' - 4"</u> | <u>10' x 2' 5 1/2"</u> |
| Progress on Inspection | <u>Forged & smoothed</u> | <u>Forged & smoothed</u> | <u>Forged</u> |
| Date when Inspected | <u>April 22nd to May 4/96</u> | <u>May 9th to June 24/96</u> | <u>April 29/96</u> |

SKETCHES OF FRAMES SHOWING POSITION AND DESCRIPTION OF WELDS OF FORGINGS, OR PARTICULARS OF TESTS APPLIED TO CASTINGS.



Welds

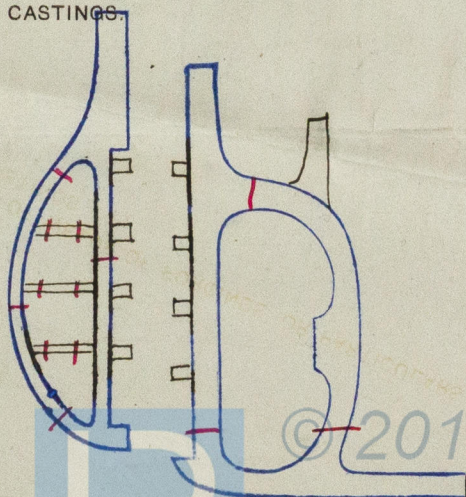

Fee (if any chargeable) £ : :

To be paid at

* If of Iron, state whether scrap or puddled Iron.

Sir Raylton Dixon & Co.

N^o 428

Report on Ships & cargoes.

"Oceano" S.S.

Made Report - N^o 1899



© 2019

Lloyd's Register
Foundation