
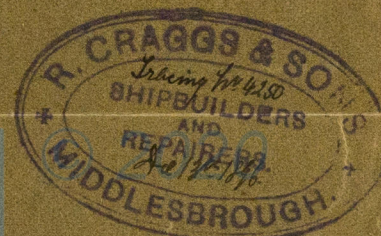


BULKHEAD N°8 FRAME

N°136 S.S.

1/2" SCALE

VERT = STIFFENING ON AFTER SIDE 5x3x1/20 A. LOOKING AFT
 HORIZ = DO - ON FORE " 7x3x1/20 B.A.

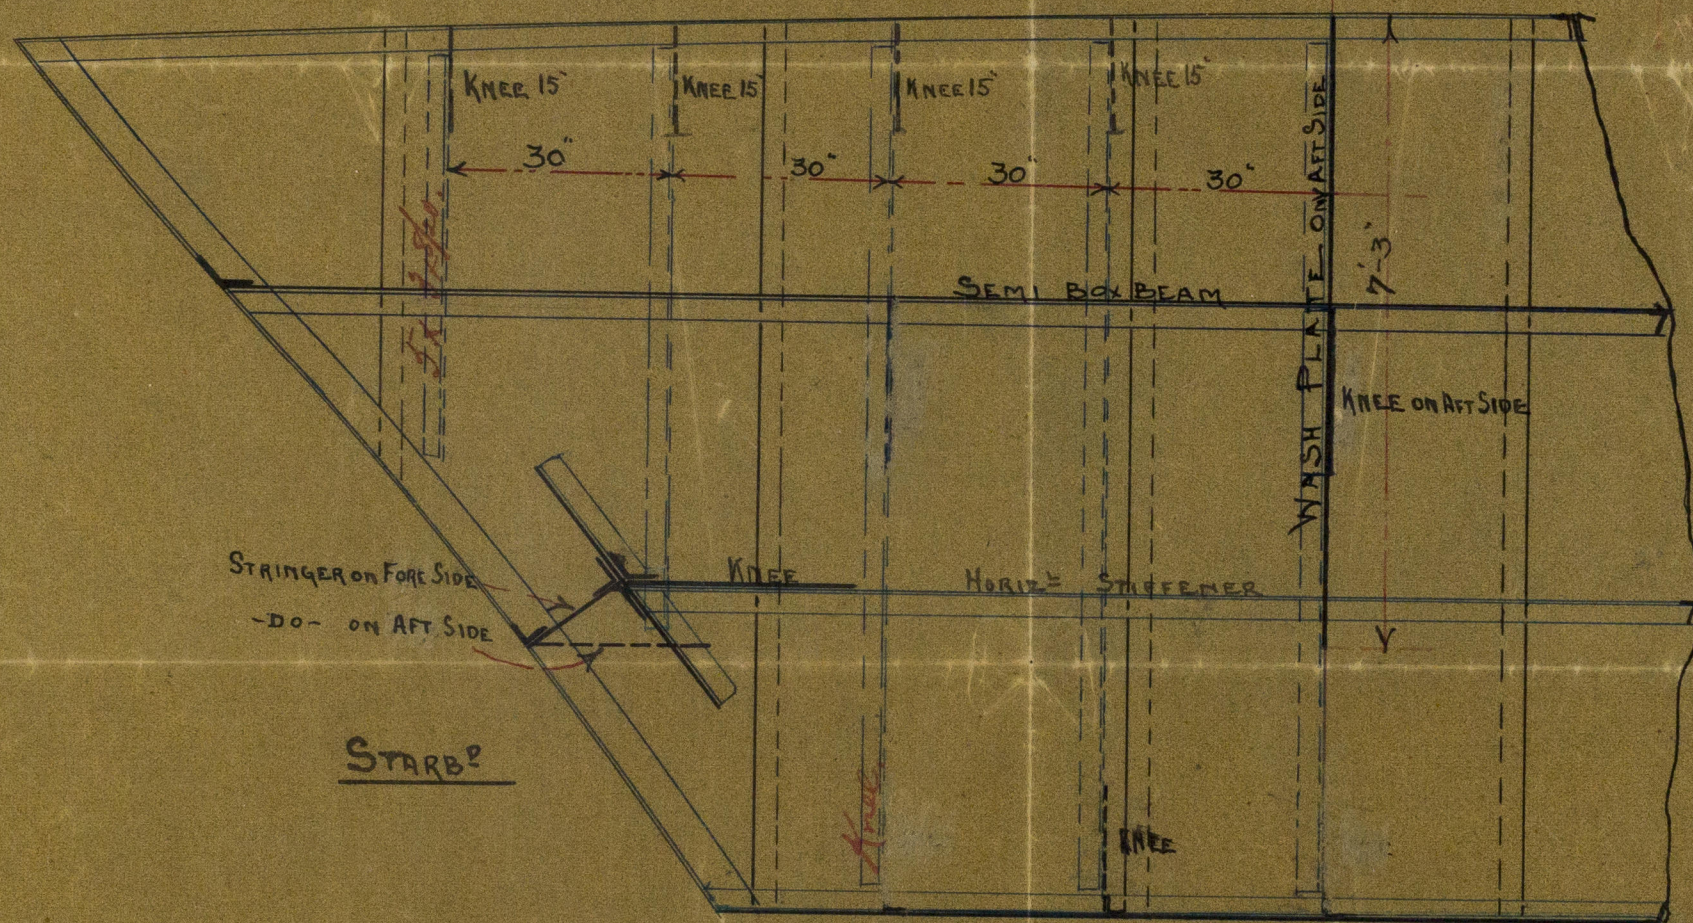

Lloyd's Register
Foundation

MDB756-0194

