


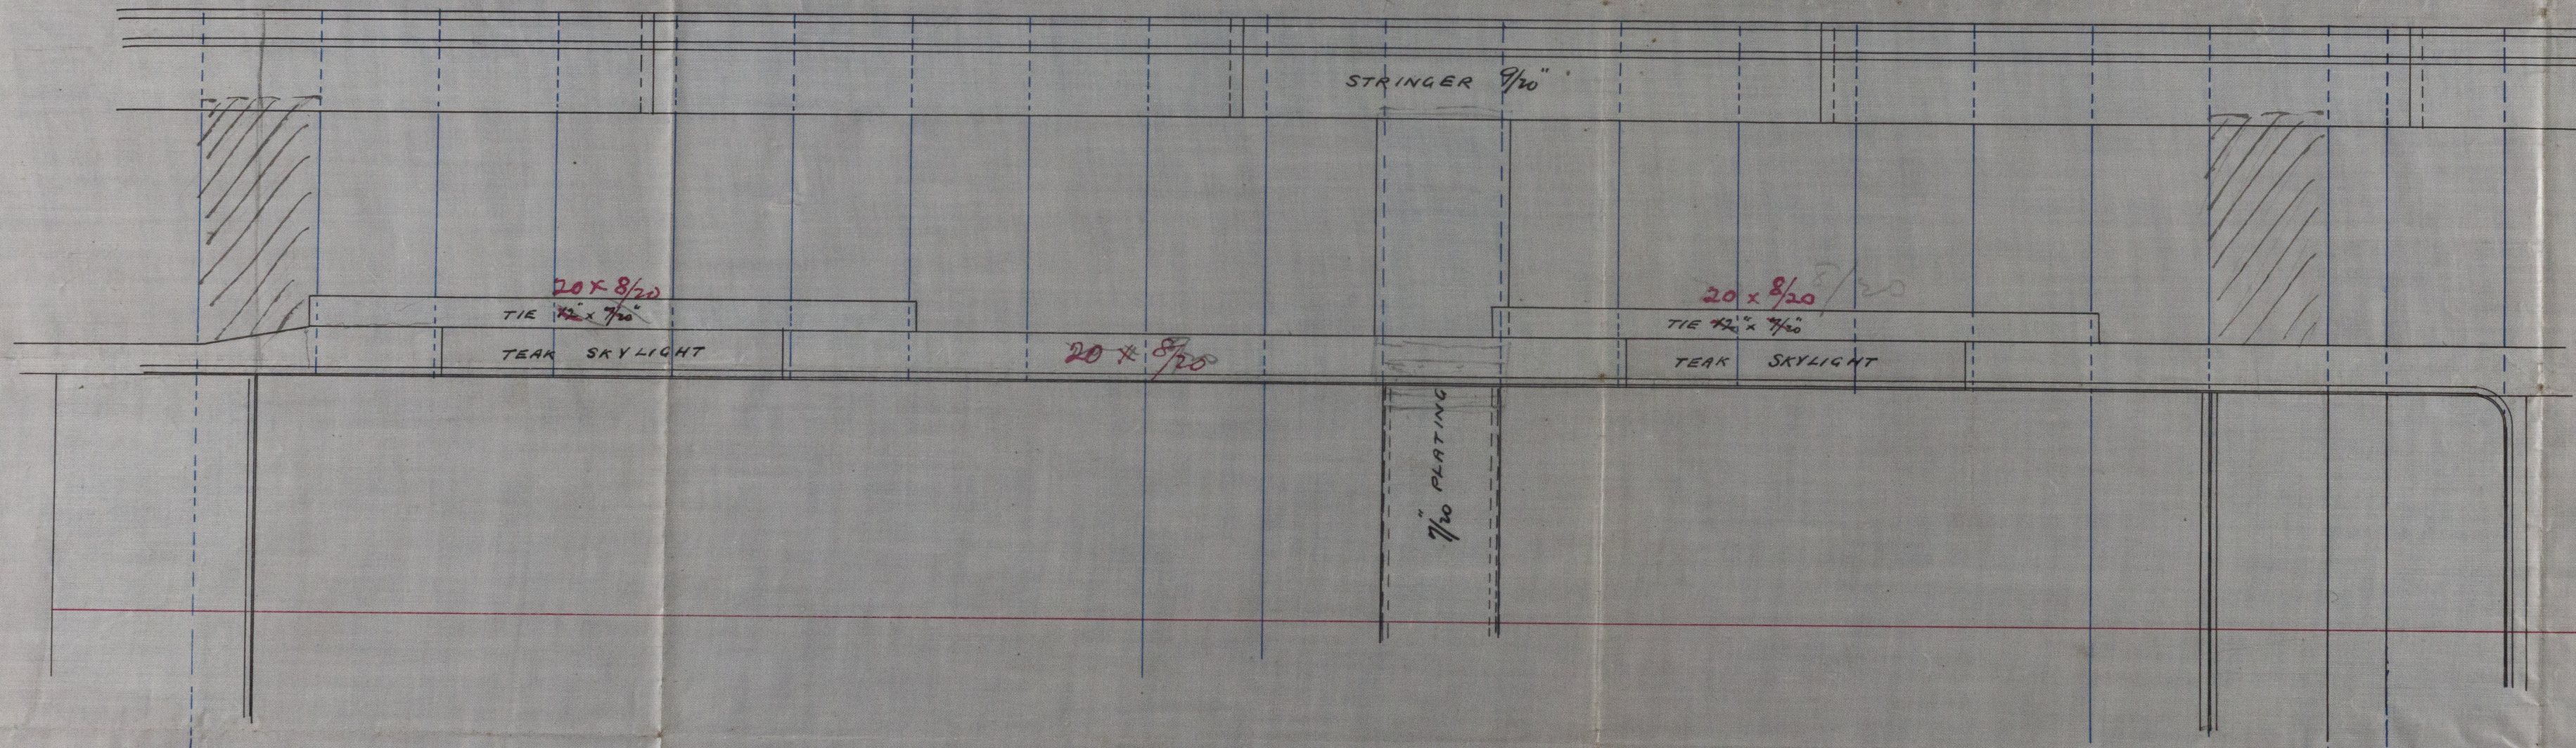

28.1.97

PLAN OF BRIDGE DK



Nº 4.4.4.

J.T.L.  
28/1/97



© 2020  
Lloyd's Register  
Foundation  
MOB757-0027




Air Raylton Dixon & Co

N<sup>o</sup> 444

Bridge Deck Plating  
in way of  
Machinery Space

S.S. "Jae-Hoku".  
Made. Repat. N<sup>o</sup> 2106

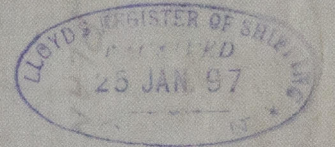

© 2020  
Lloyd's Register  
Foundation

MOB757-0027