

Received at Middlesbrough Office, 7th Apr 1897

Lloyd's Register of British and Foreign Shipping.

Middlesbrough (Report on Vessel No. _____ Port Mdb)

No. 3471a SHIP FORGINGS OR CASTINGS.

The words FORGINGS or CASTINGS, IRON or STEEL, should be struck out as may be required.

I have to report that the undermentioned Iron or ~~Steel~~ Forgings or Castings, manufactured by The Darlington Forge Co. of Darlington for the Vessel No. 444, being built by Messrs R Dixon Co. of Middlesbrough have been inspected by me as set forth below, and found to be, so far as can be seen, sound


Mark on Forgings.

Lloyd's
No. 3471a
M.C.

Wm H Cameron
Sunderland
6. 4. 97

| | STERN FRAME. | RUDDER FRAME. | STEM. |
|------------------------|---|--|---------------------|
| Material* | <u>Scrap</u> | <u>Scrap</u> | <u>Scrap</u> |
| How made | <u>Forged</u> | <u>Forged</u> | <u>Forged</u> |
| Dimensions | <u>10" x 6"</u> | <u>9" x 1 1/2"</u> | <u>10" x 2 3/4"</u> |
| Progress on Inspection | <u>Forged & Smithed</u> | <u>Forged & Smithed</u> | <u>Forged</u> |
| Date when Inspected | <u>Nov 17th to Dec 23/96</u> | <u>Jan 7th to March 11/97</u> | <u>Dec 26/96</u> |

SKETCHES OF FRAMES SHOWING POSITION AND DESCRIPTION OF WELDS OF FORGINGS, OR PARTICULARS OF TESTS APPLIED TO CASTINGS.

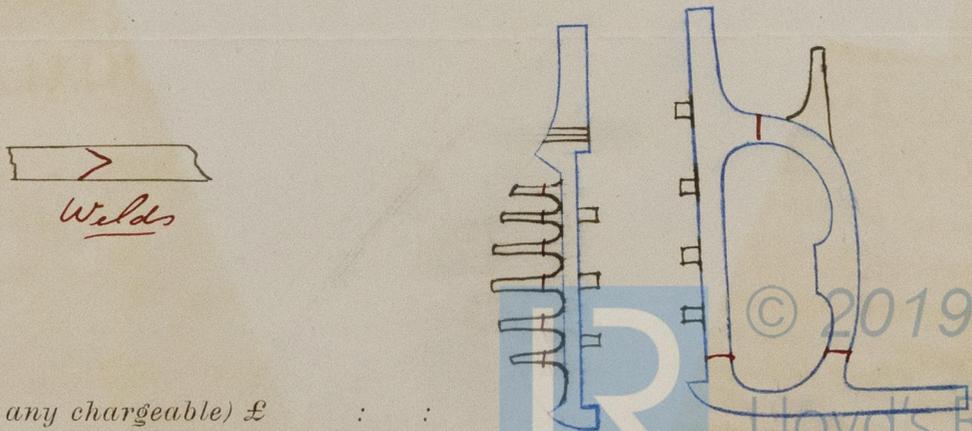

Fee (if any chargeable) £ : :

To be paid at _____

* If of Iron, state whether scrap or puddled Iron.

20 - Nov 1966

Air Raylton Dixon & Co

N. 444

Ships Forgings

S.S. Tai-Hoku.

Mold Report N. 2106.



© 2019

Lloyd's Register
Foundation