


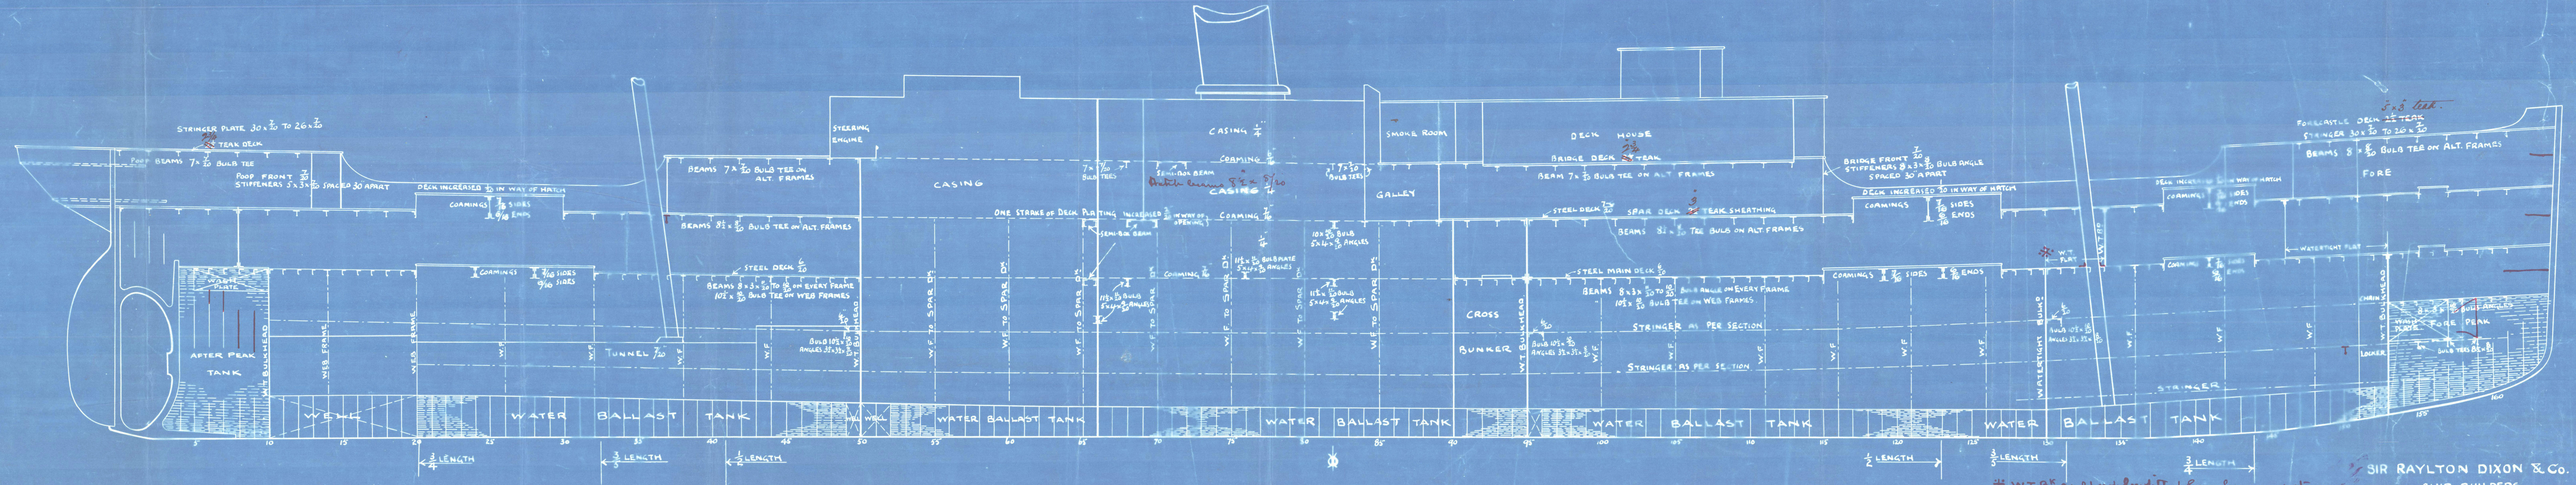

PROFILE

SCALE $\frac{1}{8}$ INCH = 1 FOOT.



Nº 444

W.T.B's could not be fitted here because of stowage
passenger accommodation a W.T. Collar
fitted round mast

SIR RAYLTON DIXON & Co.
SHIP BUILDERS
CLEVELAND DOCK YARD
MIDDLESBROUGH ON-TEES.

Sir Raylton Dixon V.C. & L.

- No 444 -

(Commended)

- Profile -

S.S. Tai - Hokew.

Mdls. Repat No 2106.

MD8757-0049



© 2020

Lloyd's Register
Foundation