

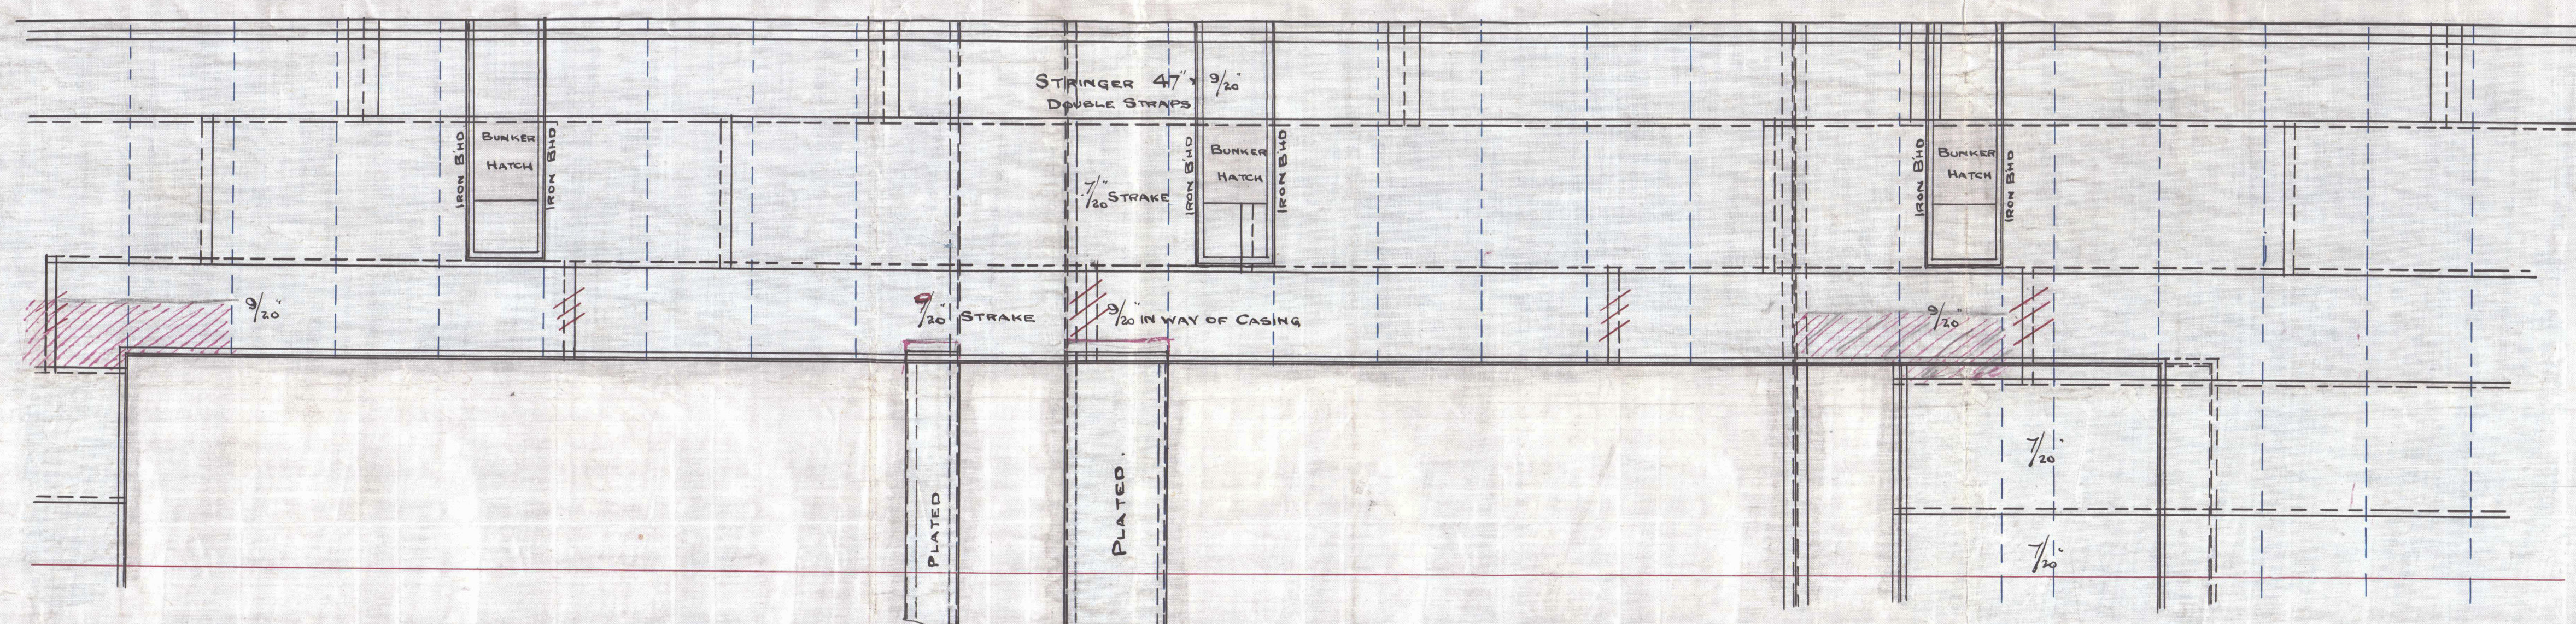
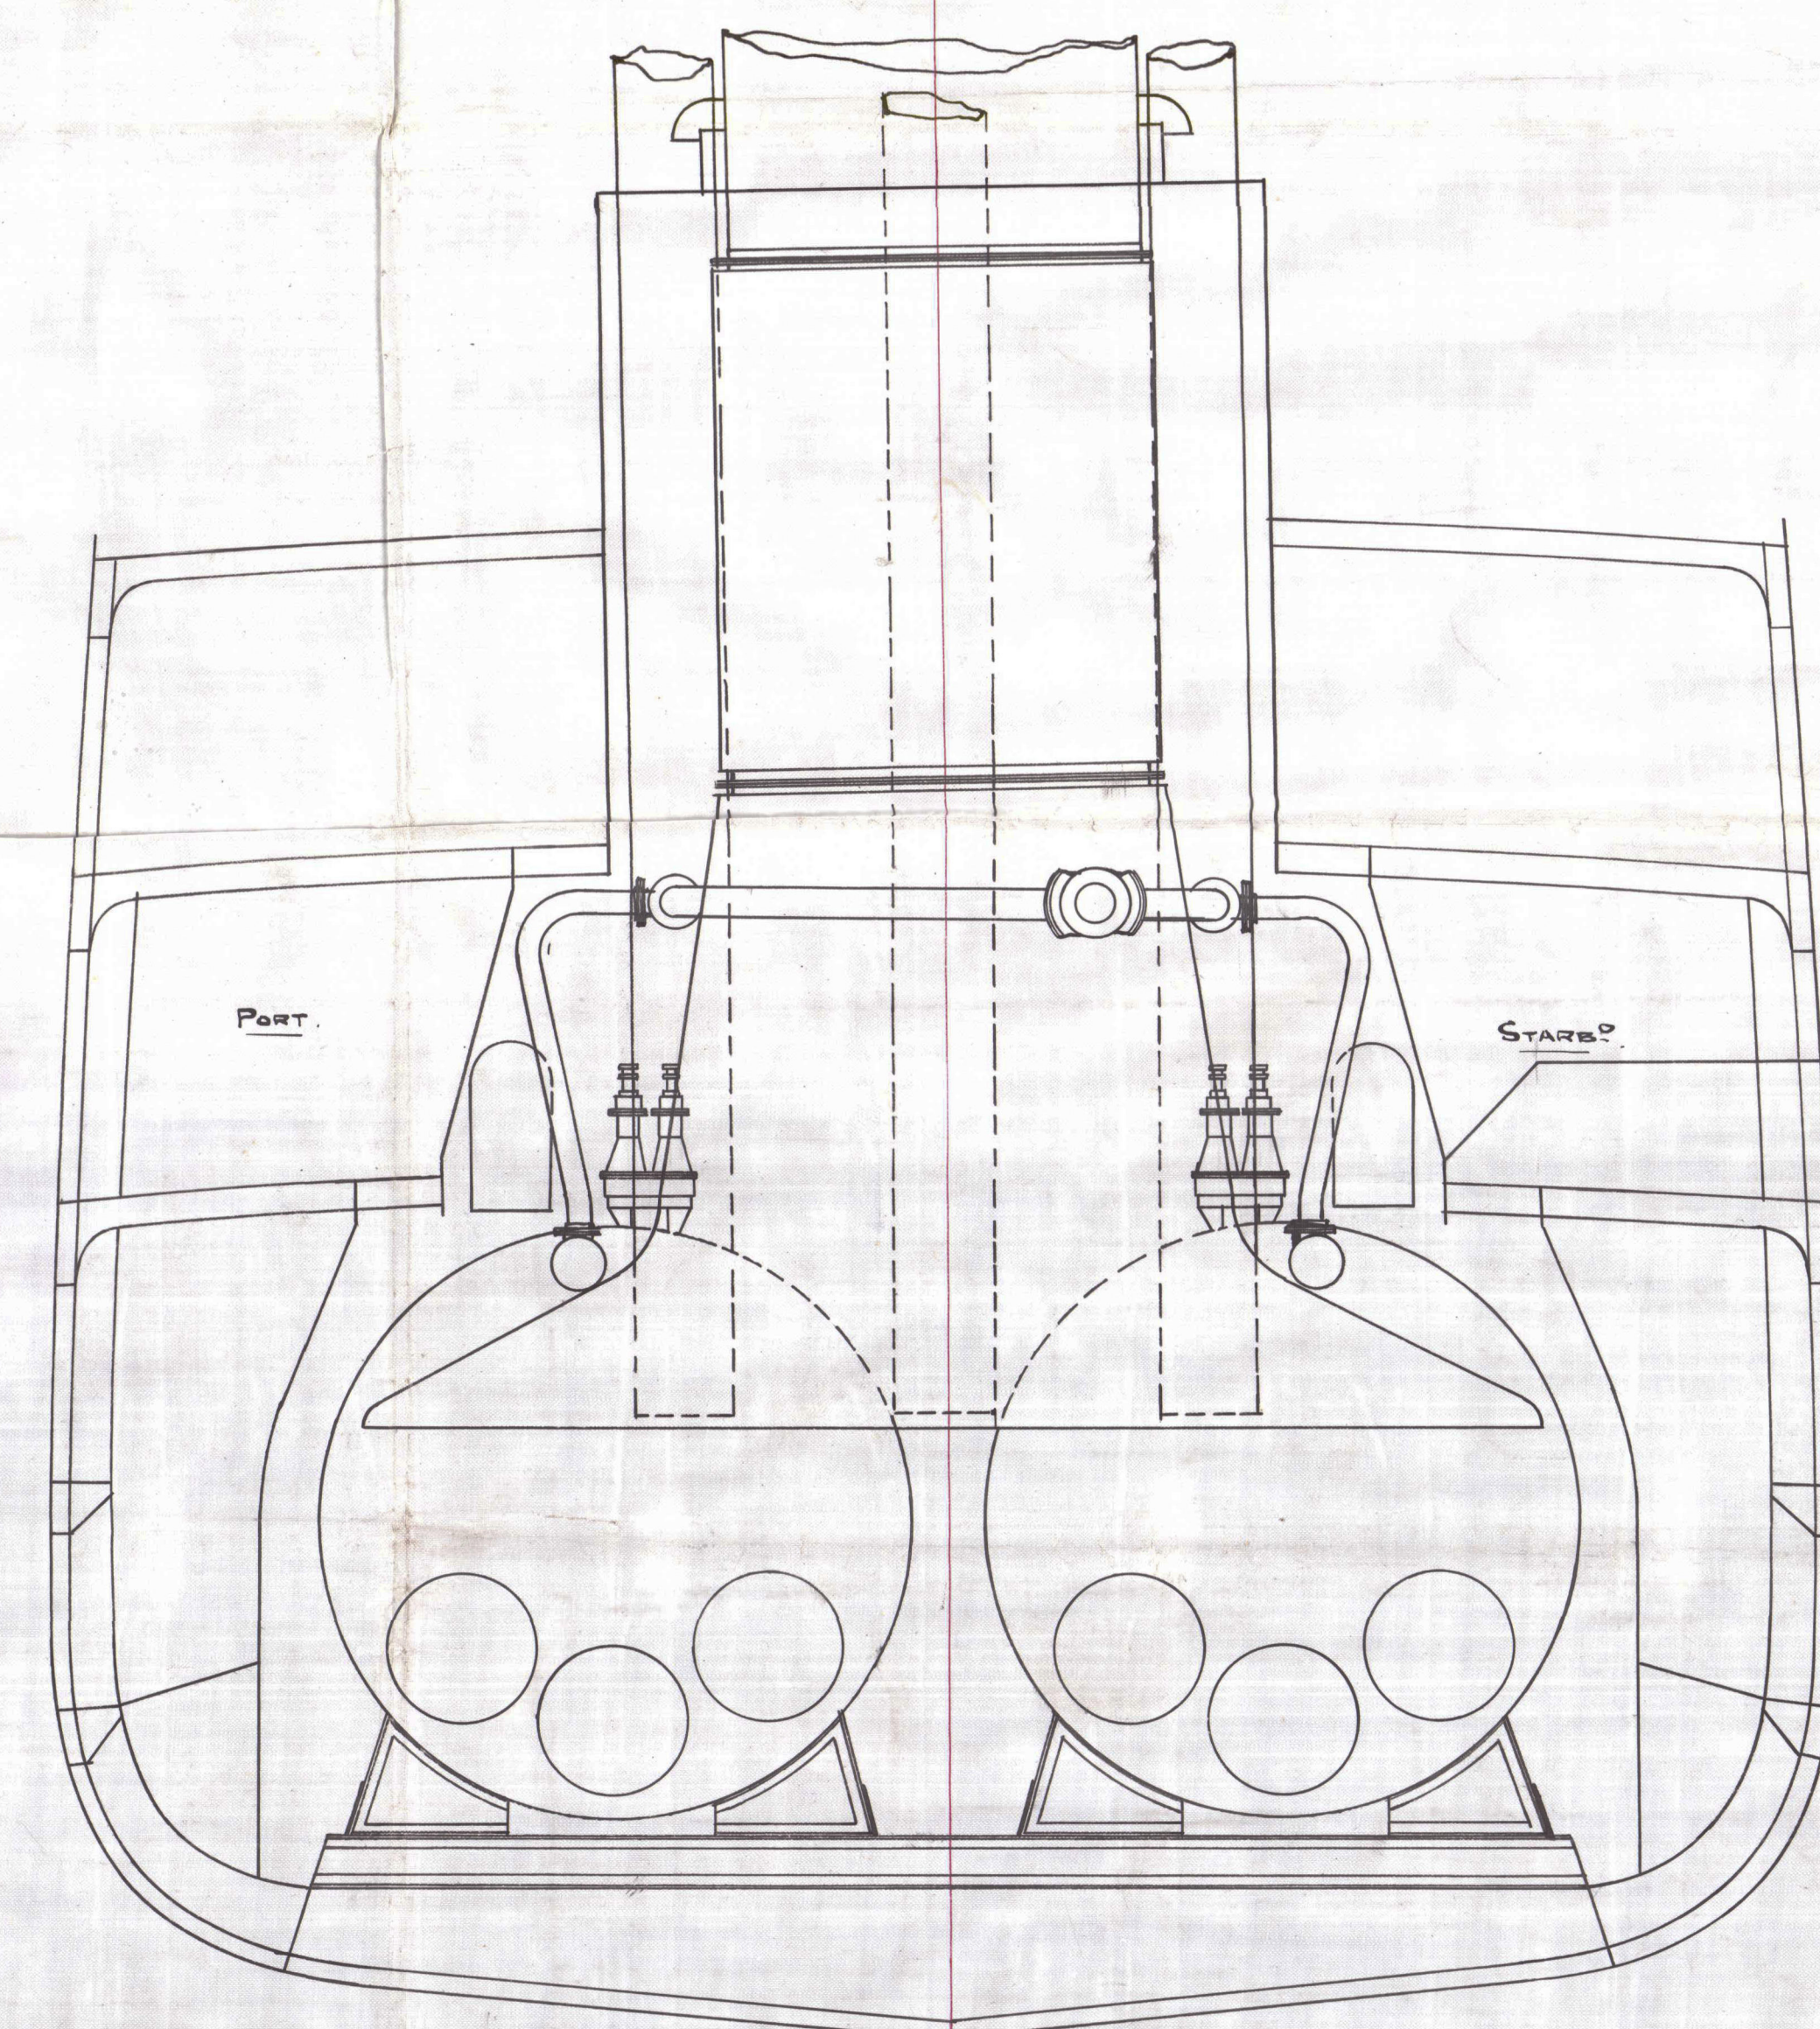


SCALE $\frac{1}{4}" = 1 \text{ FOOT}$.

28. 1. 97

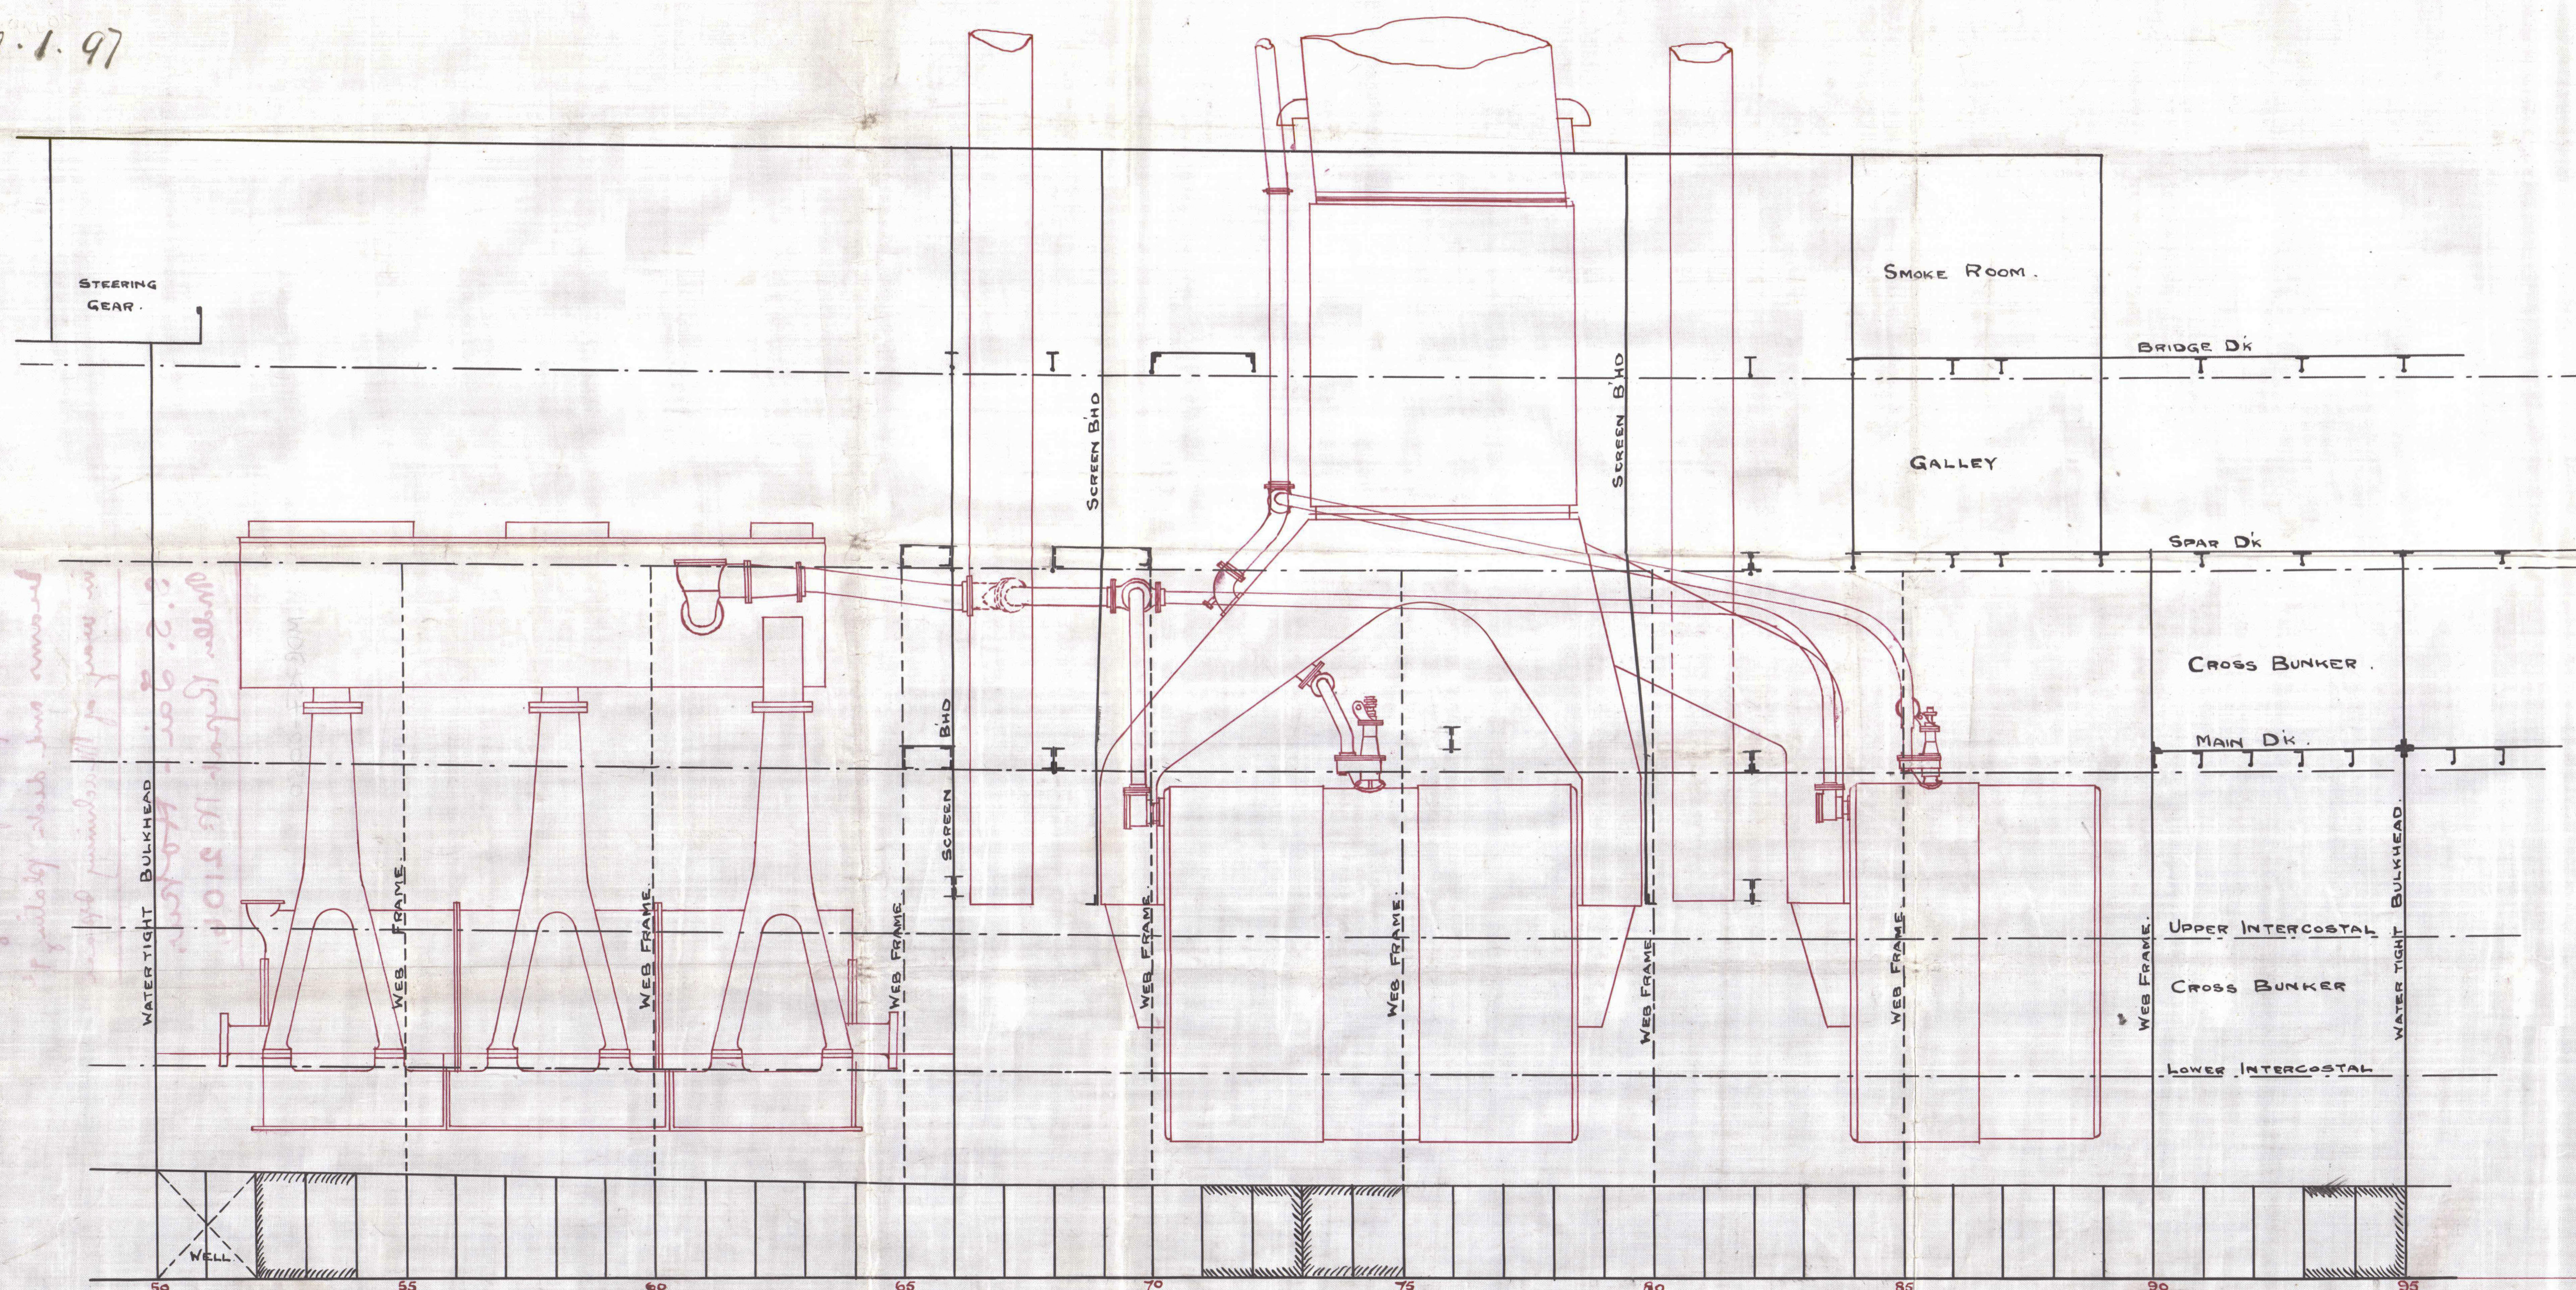


PLAN OF SPAR D'K

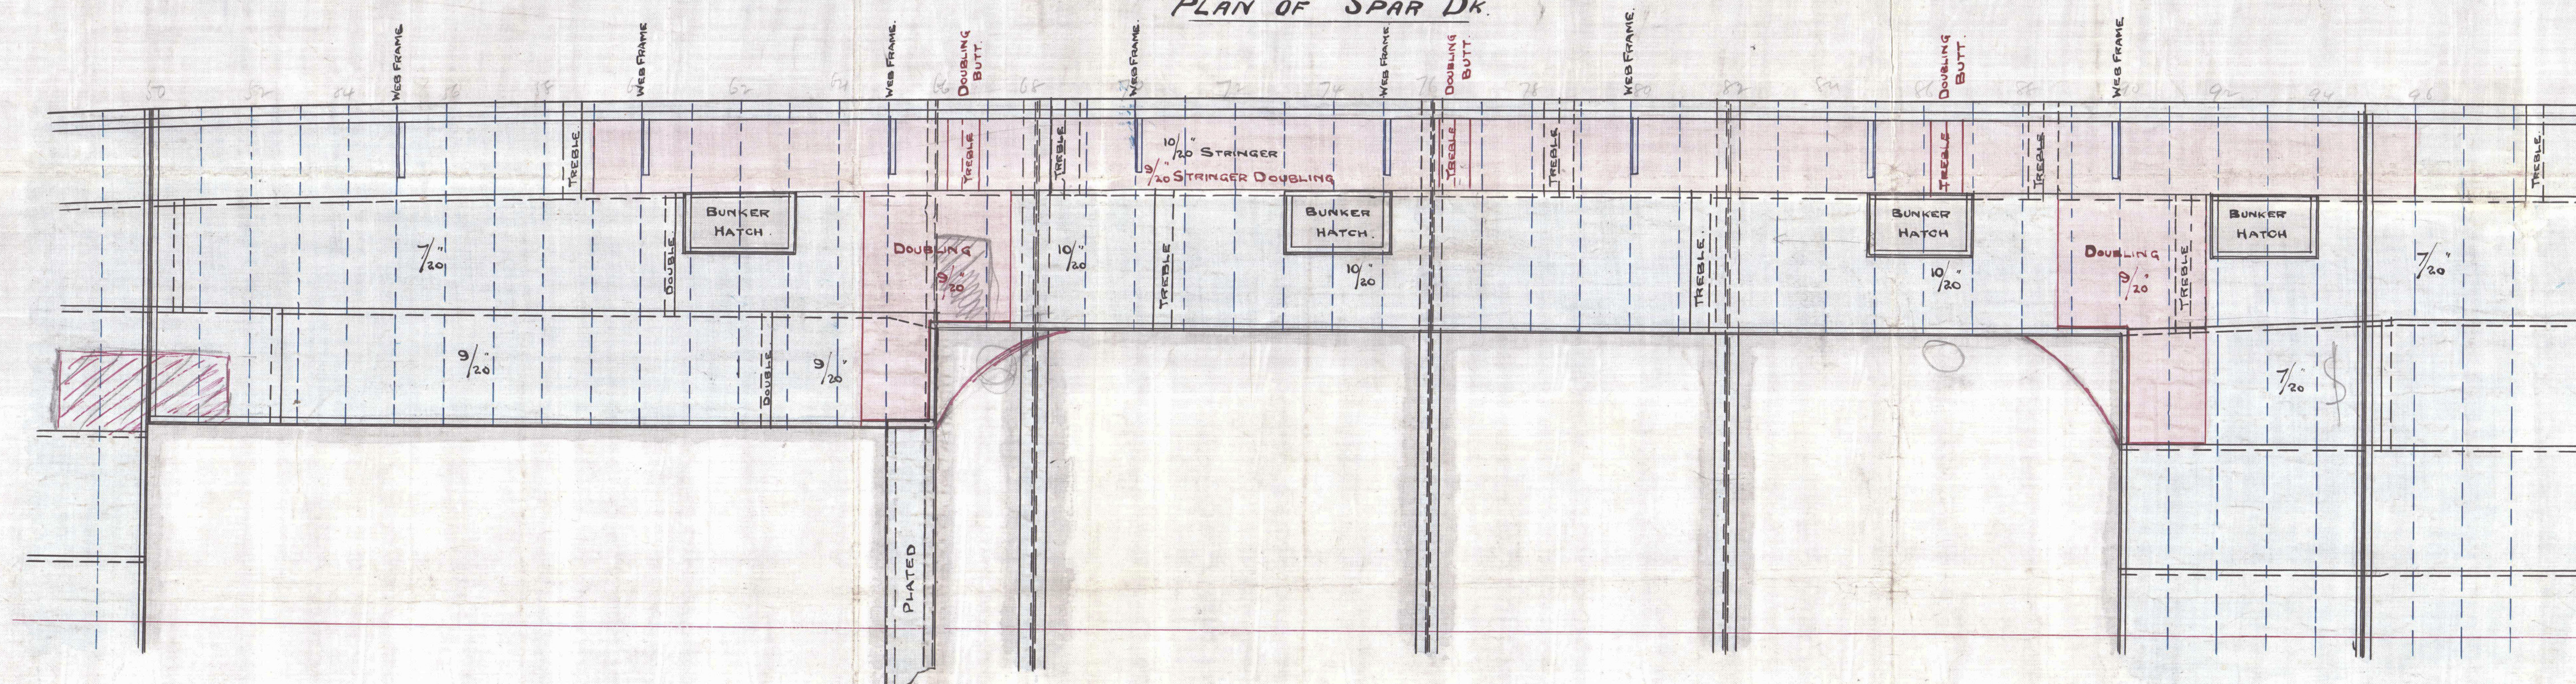

PLAN OF MAIN D.K.

Nº 444.

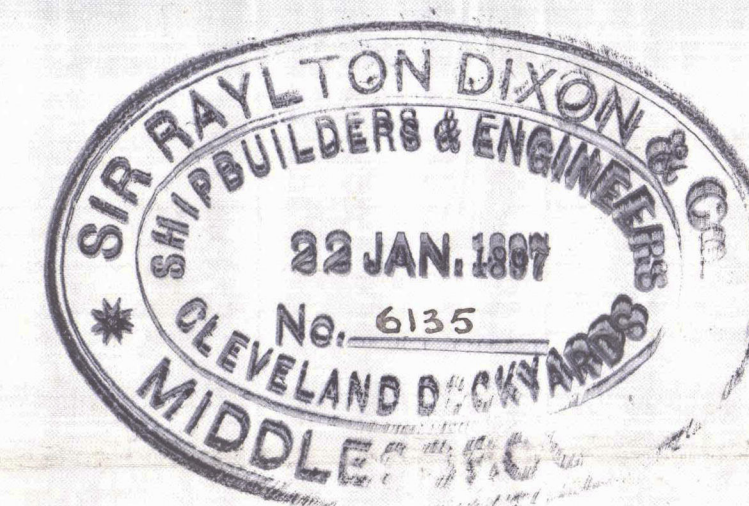


On Raylton Dixon & Co:

N-444.

Amended plan of through
beams and deck plating
in way of Machinery space

S.S. Tai-Hoku,
Under Repair N-2106,

MOB757-0050

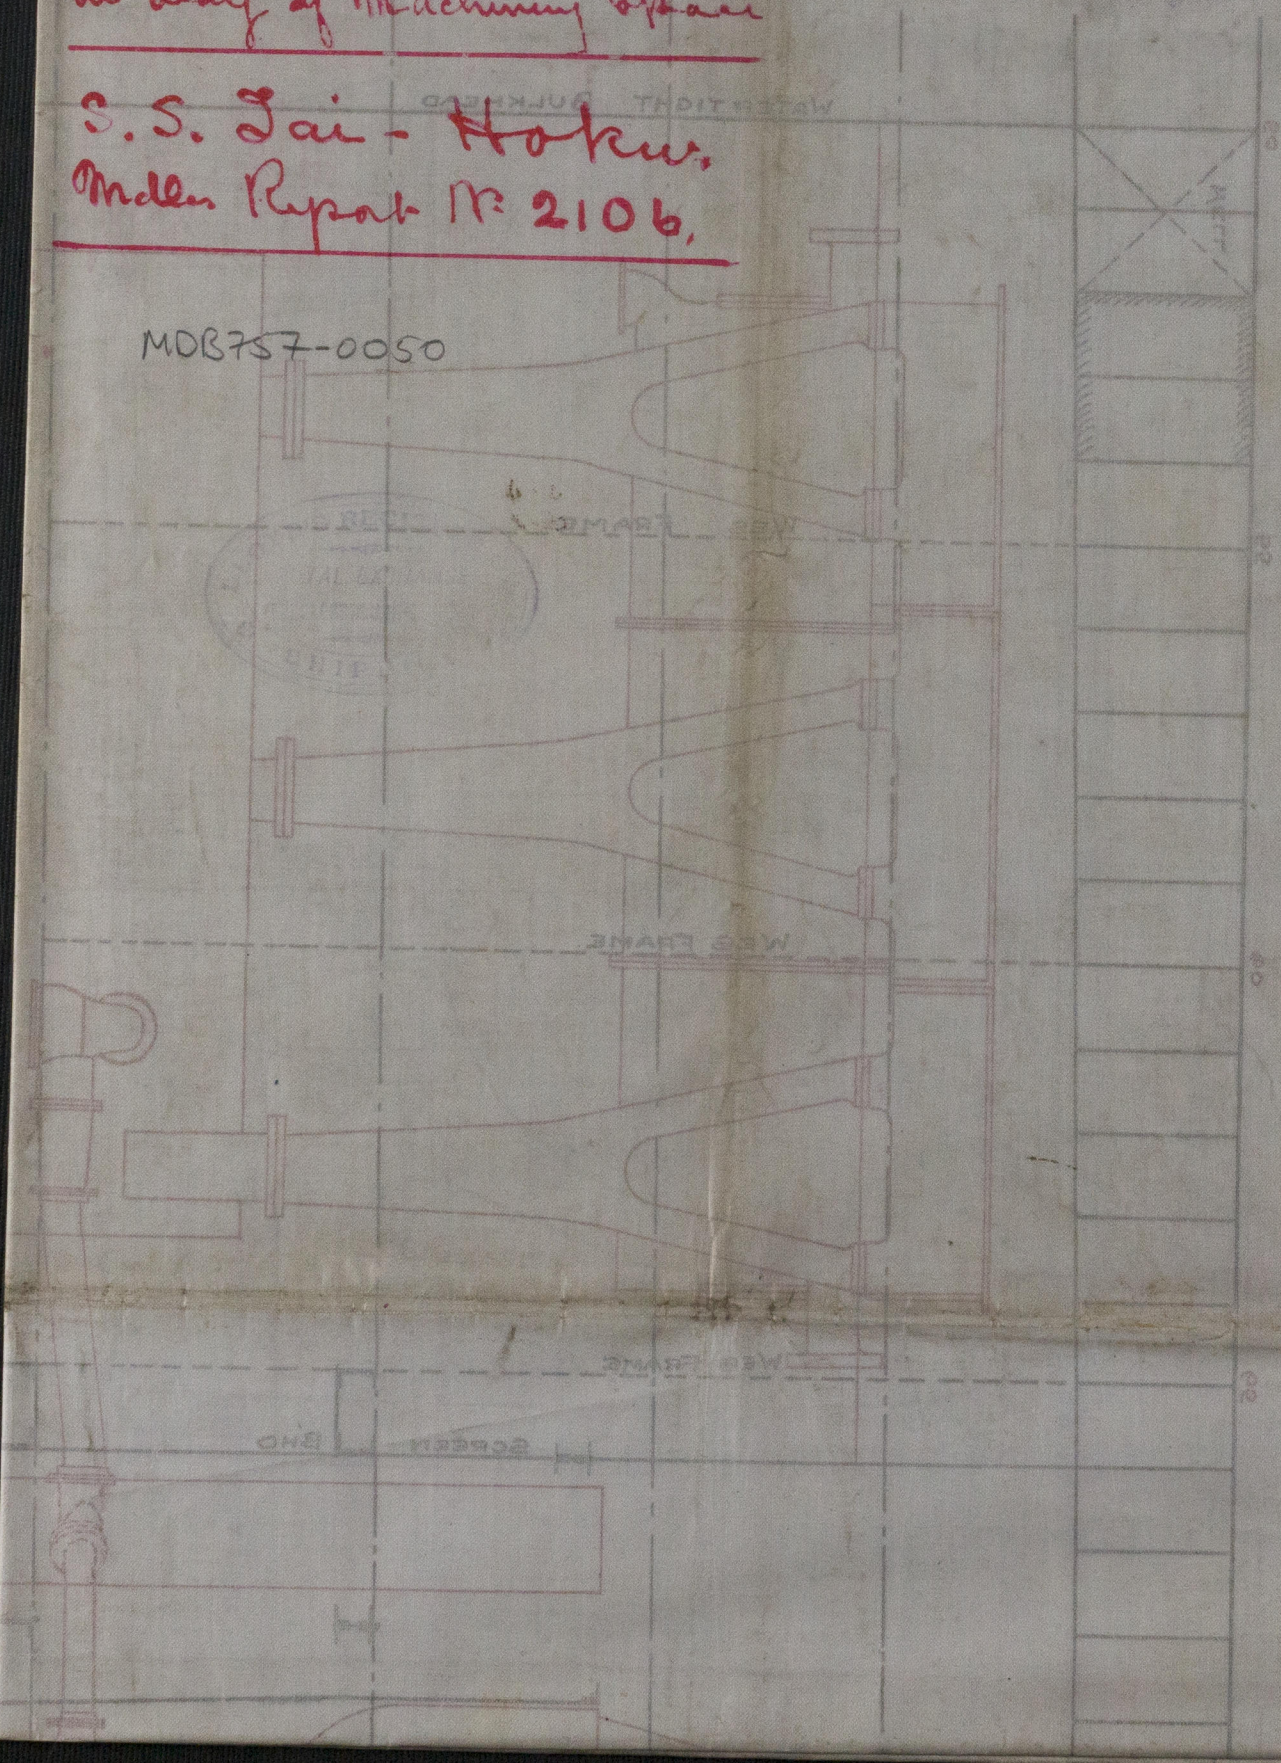

PLAN OF MACHINERY SPACE



© 2020

Lloyd's Register
Foundation