


Marine Engine 18.1336.

BLAIR & COY., LTB  
ENGINEERS,  
17-DEC-97  
STOCKTON-ON-TEES.

Apr  
23.12.97  
LONDON

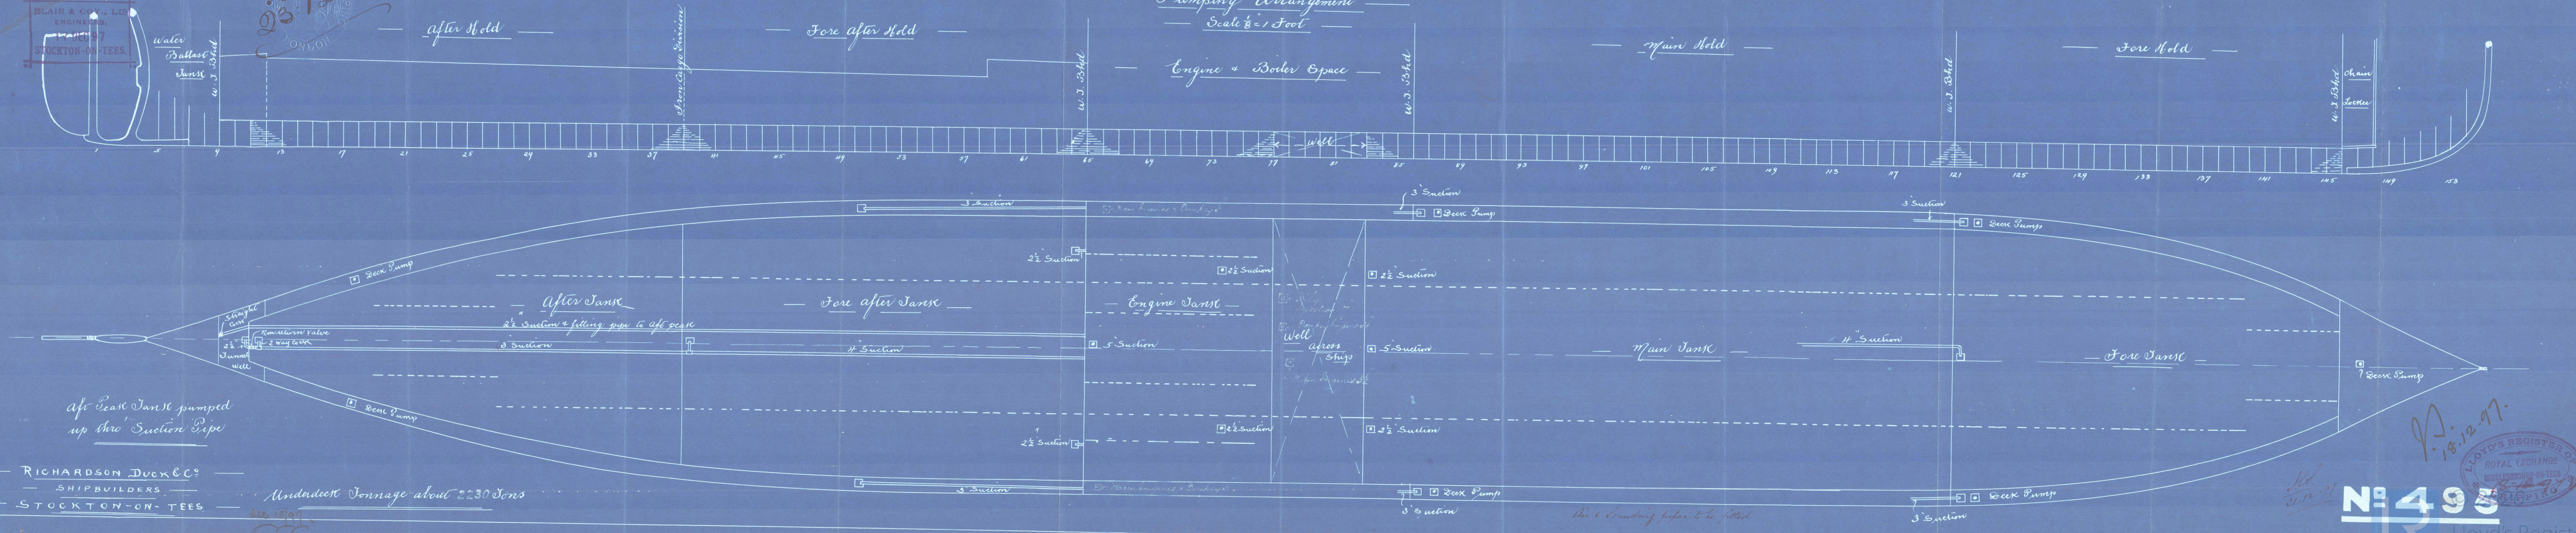

RICHARDSON DUCK & CO  
SHIPBUILDERS  
STOCKTON-ON-TEES

Underdeck Tonnage about 2230 Tons

Dec 15.97

18.12.97

LOYD'S REGISTER OF  
ROYAL EXCHANGE  
MIDDLERBROUGH-ON-TEES


Lloyd's Register  
Foundation  
MSB-59-0130





Pumping Plan  
Richardson Ductee

No 495

S.P. Clara

Water Report No 2381

MDB759-0130



© 2020

Lloyd's Register  
Foundation