

of Clara

Received at Middlesbro Office, 22<sup>nd</sup> April 1898

Lloyd's Register of British and Foreign Shipping.

(Report on Vessel No. 2381 Port Mal)  
Middlesbro

No. 3690 a. SHIP FORGINGS OR CASTINGS.

I have to report that the undermentioned Iron or Steel Forgings or Castings, manufactured by Messrs Wad Wighton & Co. of Stockton for the Vessel No. 495, being built by Messrs Richardson Duck & Co. of Stockton have been inspected by me as set forth below, and found to be, so far as can be seen, sound

Mark on Forgings.


Lloyd's  
No. 3690 a.  
80.6

Hugh Cameron

Sunduland  
21.4.98

	STERN FRAME.	RUDDER FRAME.	STEM.
Material*	Scrap	Scrap	Scrap
How made	Forged	Forged	Forged
Dimensions	11' x 6"	8' x 14"	10 1/2' x 2 3/4'
Progress on Inspection	Forged & Smithed	Forged & Smithed	Forged
Date when Inspected	Oct 19/97 to Feb 24/98	Feb 3 <sup>rd</sup> to March 16/98	Feb 14/98

SKETCHES OF FRAMES SHOWING POSITION AND DESCRIPTION OF WELDS OF FORGINGS, OR PARTICULARS OF TESTS APPLIED TO CASTINGS.

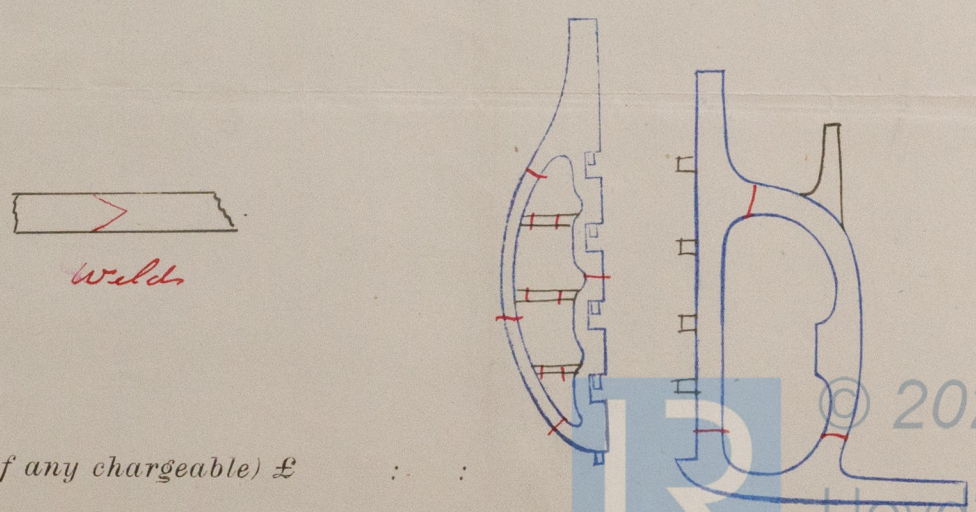

Fee (if any chargeable) £ : :  
To be paid at