




ELEVATION.

310' 0" x 44' 0" x 22' 10 1/2" MLD.


SCALE 1/8" = 1 FOOT.

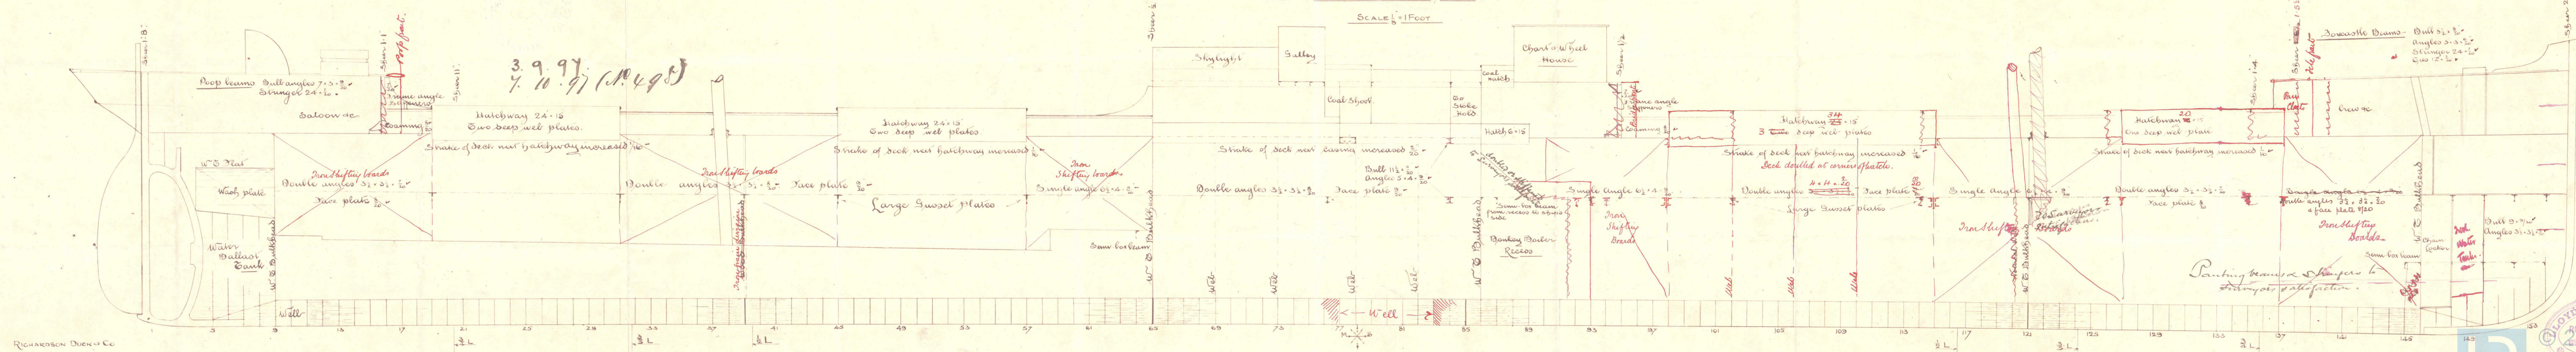

RICHARDSON DUCK & CO
SHIPBUILDERS
STOCKTON-ON-TEES.
Aug 31/97

3/9/97


LLOYD'S REGISTER OF
SHIPPING
ROYAL EXCHANGE
BUILDING LONDON
No 194.
MD 3759-0136

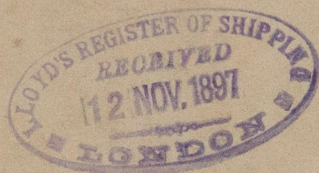

Profile.
Richardson Duck & Co.

No ~~494~~ 495
(new plans submitted for 494)

J. S. Clara
Intro Report No 2381

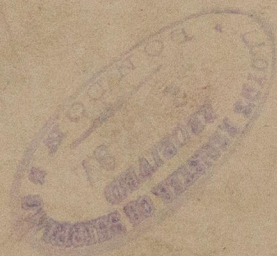

MDB459-0136



© 2020

Lloyd's Register
Foundation