

Class 100 A1 Loyds Steel
Scale $\frac{1}{2}$ - 1 foot

(No 495) 3.9.98.
4. 10. 98

Pillars $2\frac{3}{4}$ -

Half breadth	21.9
Depth	23.75
Half Girth	41.83
1st Gummer	87.48

2nd Number - 26961 ✓

Equipment 16° ²⁸³⁵⁹ ~~28295~~

Depth in Length 12.9.

Breadth in Length 7.03

Equipment — (E)

2 Bowlers	42' 2" cut	stockless
1 do	36 1/4"	
1 stream	10 3/4"	4 stock
1 hedge	5 1/2"	
240 jathoms	1 1/2"	2nd chain cable
75 do	4 1/2"	mooring wire
100 do	4"	steel bow line
90 do	3 1/4"	hawser
90 do	8"	Manilla warp

→ Iron Shifting Boards $\frac{5}{16}$ thick

Stiffeners - double angles $6 \times 3\frac{1}{2} \times \frac{9}{16}$ 4 ft apart, in Main & Fore Holds.

$$5 \times 32 \times \frac{9}{20}$$

Double lugs between beams at deck. 3-3.

Frames $5\frac{1}{2} \times 3\frac{1}{2} \times \frac{8}{20}$ for $\frac{3}{5}$ of 10' 20" - 24 apart ✓

Per Frames $4 \times 3\frac{1}{2} \times \frac{1}{20}$ to 116 am & lower decks alternately.

double in tank in E & B space, alternate in frames to 1000.



13 milkheads 20 - 20 Flours by rule 25 - 20 for 5 & 10 20

Gault Cop } 20 in Hold }
16 in B Room } Butts double run for 1/2 L.
6 in B Room }

920 for 26 to 20
tutto double in
double -

$I = A \times \frac{1}{2} \times 8 \frac{1}{2}$

Bulls Creek riv. caps.
24.18

Double for $\frac{1}{2} \times 2$ Continuous $\frac{1}{2} \times 4$

$36 \times \frac{16}{20}$ for $\frac{1}{2}$ L
 $3 \frac{1}{2}$ L to $\frac{16}{20}$
 to be increased $\frac{1}{2}$ L for $\frac{1}{2}$ L
 $12 \frac{1}{2}$ for $\frac{1}{2}$ L
 to be increased

$$= \frac{18}{20}$$

From keel to main deck all shell butts lapped and rabbled inside. 3 complete rows of shell (ex plate keel + butts) where "90 or above to be reduced" in way of double bottom. Boss plate and plate above + below $\frac{3}{20}$ thicker than plates amidships. Tank floors, ^{main plate} reverse frames intercostals, ^{lugs} increased '90 under boilers.

RICHARDSON DUCK & CO
SHIPBUILDERS
STOCKTON-ON-TEES

Aug 31/97



LLOYD'S REGISTER OF
ROYAL EXCHANGE
WIDLESBROUGH-ON-TEES
1-9-71
SHIPPING

Nº 495

Vol. 495 appo. 4/10/98.



WDB49-0137

Midship Section
Richardson Duck & Co

No ~~484~~ 495

(new plans submitted for 494)

S. P. Clara
Intro Report - 2381

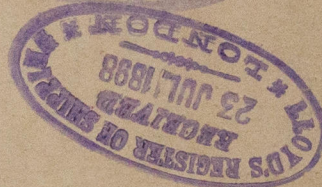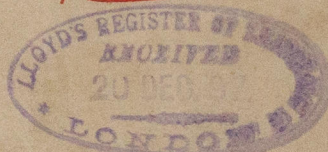

MDB 759-0137



© 2020

Lloyd's Register
Foundation