3 BOILERS No. 1050

TO BE FITTED TO MESSRS SIR RAYLTON DIXON & Cos S.S. No 449
TO PASS BOARD OF TRADE FOR A WORKING PRESSURE OF 180 LBS PER SQ INCH
" " LLOYDS " " " " 180 " " " "
TO BE TESTED IN THE PRESENCE OF BOARD OF TRADE AND LLOYDS SURVEYORS.

TENSILE OF SHELL PLATES 28 TONS PER SQ INCH.

SCALE 1 in = 1 Foot.

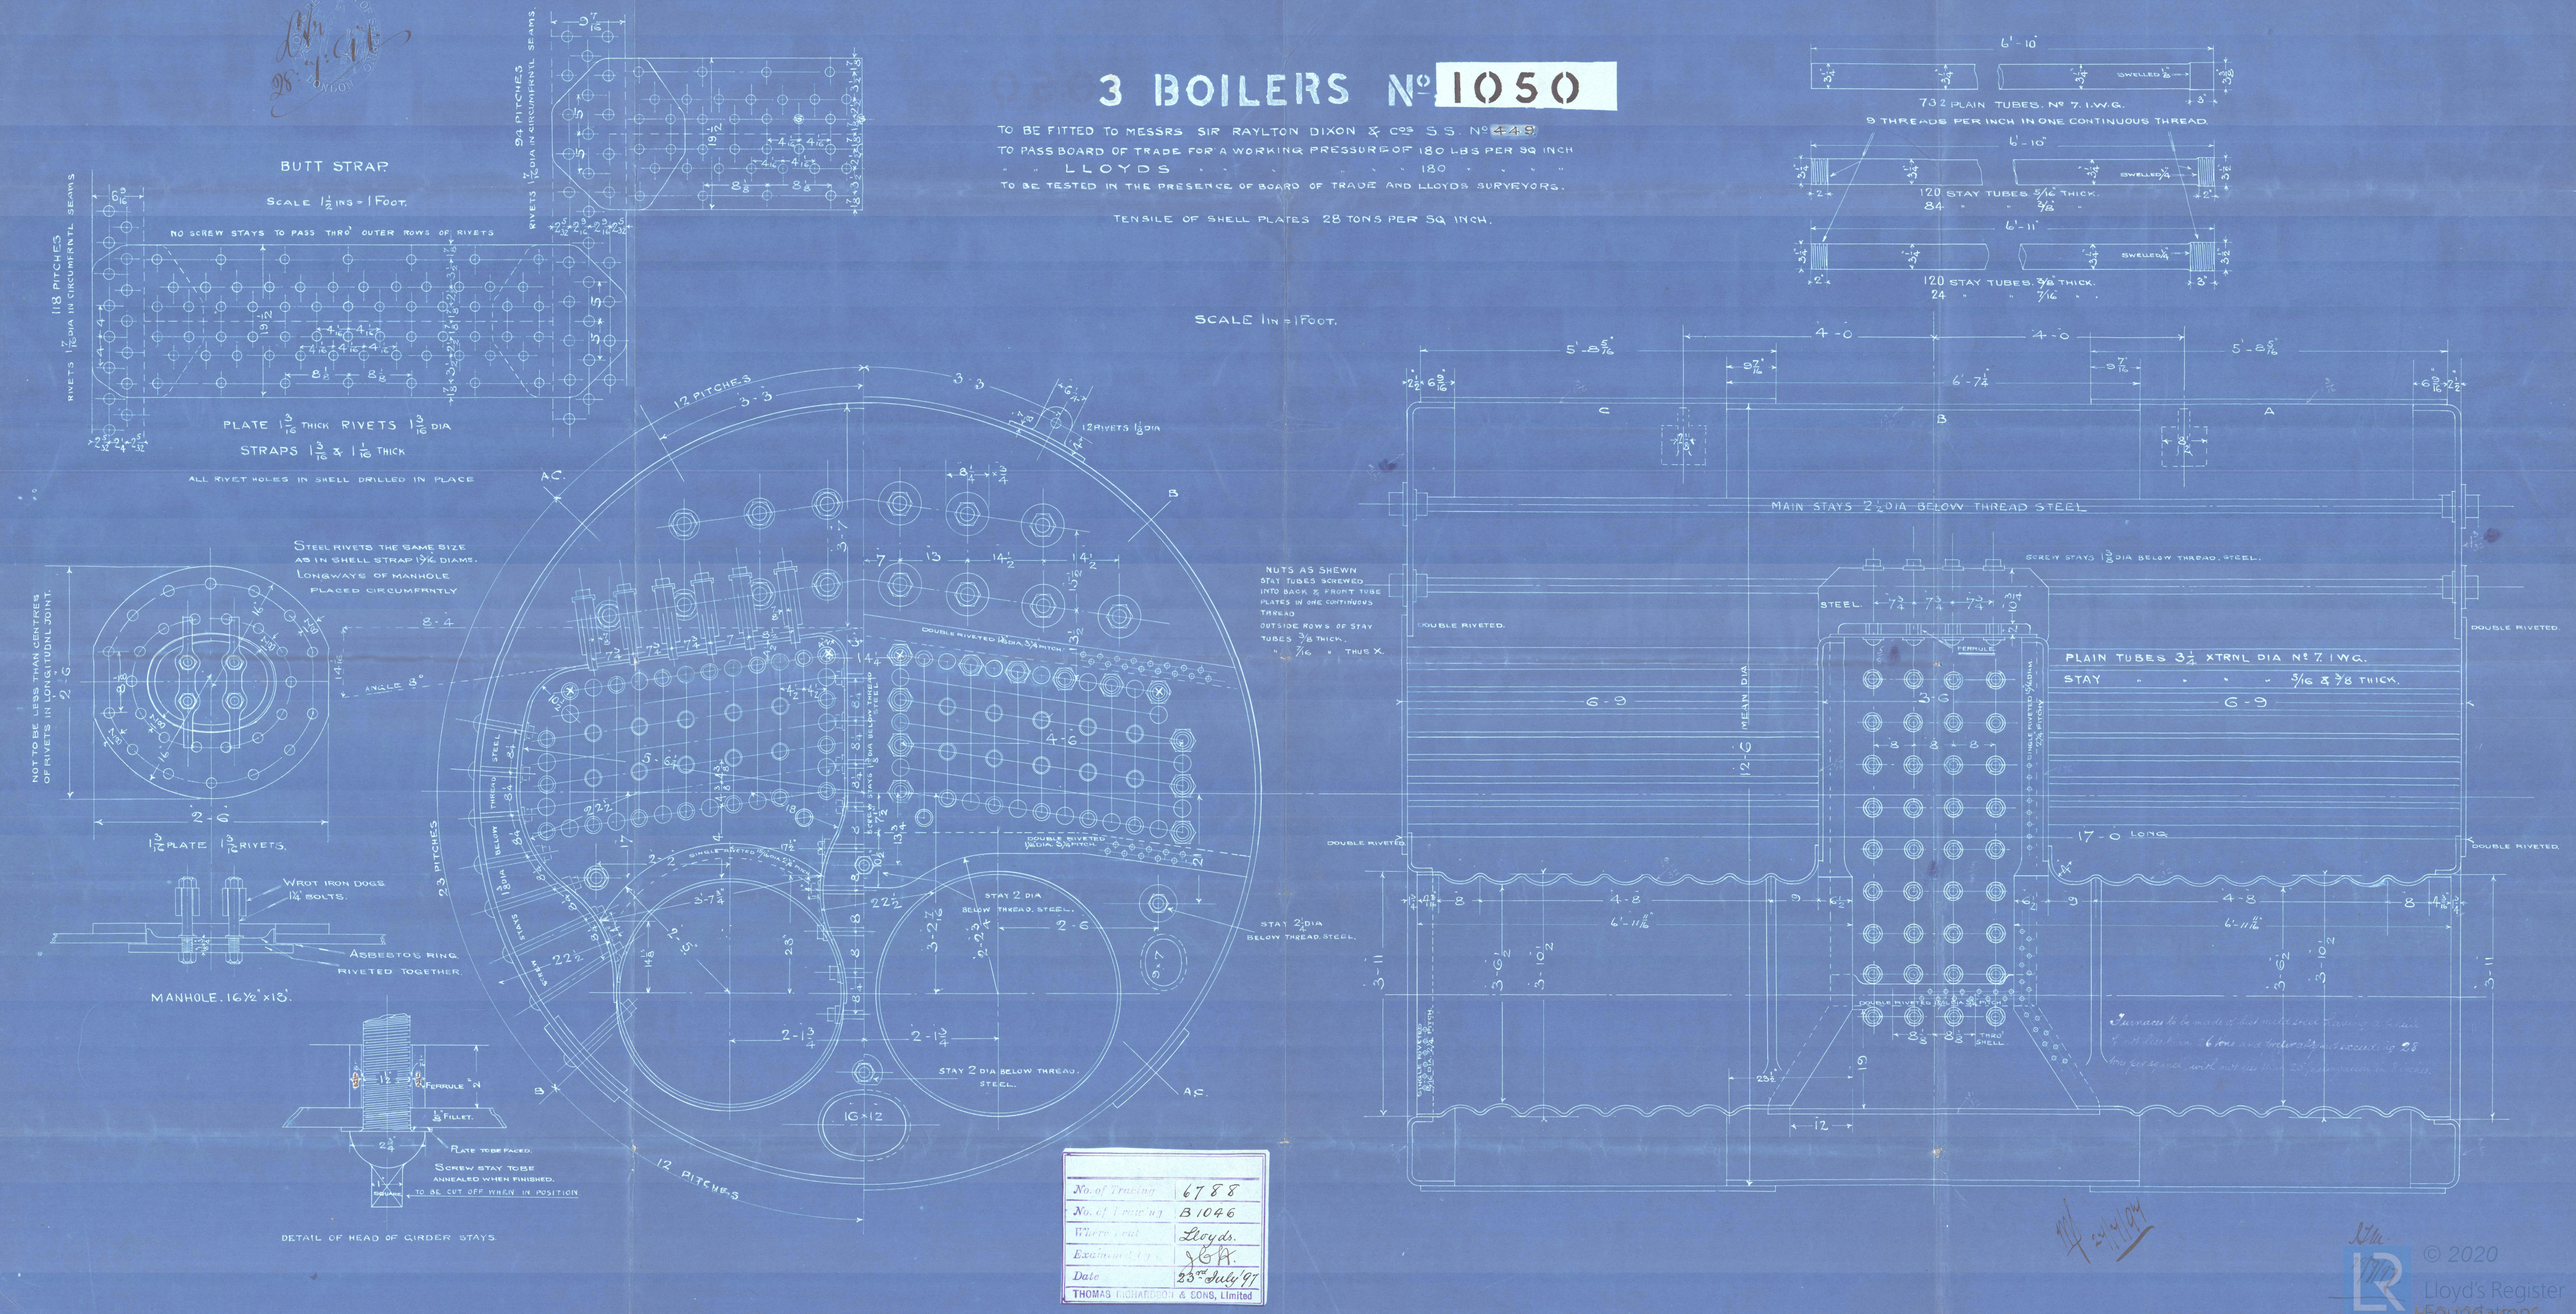

No. of Tracing	6788
No. of Drawing	B1046
Where sent	Lloyds.
Examined by	J.G.R.
Date	23rd July 97

THOMAS RICHARDSON & SONS, Limited

© 2020 Lloyd's Register Foundation

LLOYD'S REGISTER OF SHIPPING
RECEIVED
28 JUL 1897
LONDON

Sir R. Dixon & Co.

No. 449 Vessel

J. Richardson Hons.

1050

180 lbs. N.P.

Boilers

No. 2604
Lloyd's Test
300 lbs.
W.J.S. 10.3.98

s.s. ~~"G. [illegible]~~ "Albertville"

W. Hpool. Report
No. 10595

Intro report No. 2406

LLOYD'S REGISTER OF SHIPPING
RECEIVED
1 - 3[illegible]
LONDON

MB3795-0196

© 2020
Lloyd's Register
Foundation