

— SCALE $\frac{1}{8}"$ = ONE FOOT. —






4. 6. 97
13. 8. 97

PROFILE.

352'-0" x 44'-0" x 26'-0" U.D.

SCALE 1/8" = ONE FOOT

Cent with Freeboard Report
Please return when done will
M.D. 759-0177 (1/2)

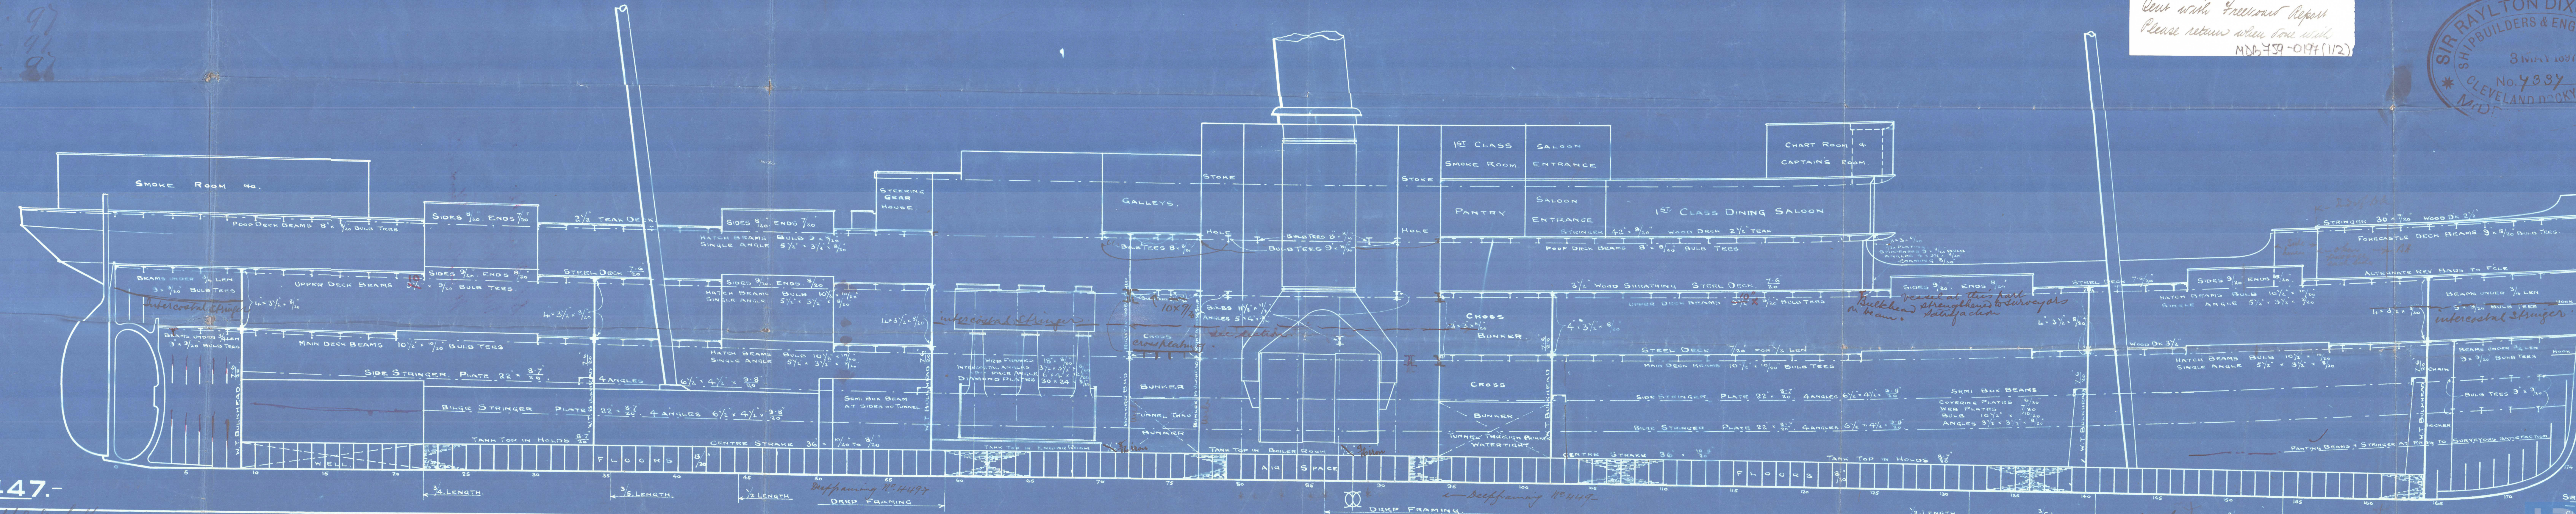

-No 447-



447 app'd by 22/4/97

Deck Framing 11-4497

Deck Framing 11-4497

5/6/97



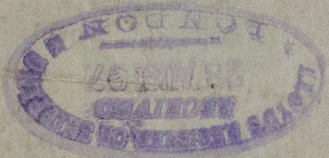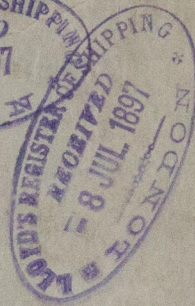

Sir Raylton Dixon & Co:
N^o 447

Amended Profile.

& No: 449 see letter
22/7/97




Ss. "Bruxellesville"
Mbro. Report N^o 2301

N^o 449- "Albertville"

Mbro report No 2406



MD5759-0197

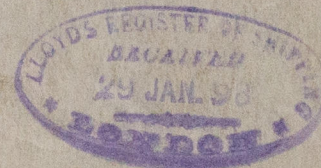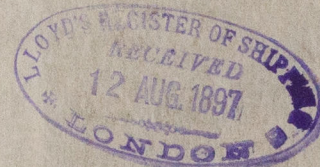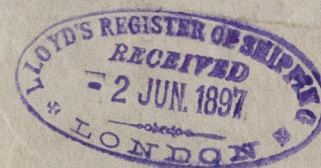

© 2020

Lloyd's Register
Foundation