

s/s 'Peerless'

Received at Middlesbrough office, 10<sup>th</sup> June 1898

## Lloyd's Register of British and Foreign Shipping.

Middlesbrough (Report on Vessel No. 2455 Port Mal)

No. 3730.2

## SHIP FORGINGS OR CASTINGS.

I have to report that the undermentioned Iron ~~or Steel~~ Forgings ~~or Castings~~,  
 manufactured by Messrs Wad Knighton & Co.  
 of Stockton for the Vessel No. 496, being built  
 by Messrs Richardson Duck & Co. of Stockton  
 have been inspected by me as set forth below, and found to be, so far as can be seen,  
 sound

Mark on Forgings.

Lloyd's  
 No 3730.2  
 R.C.


W. J. Hamson

Sunderland  
9.6.98

	STERN FRAME.	RUDDER FRAME.	STEM.
Material* ...	Scrap	Scrap	Scrap
How made ...	Forged	Forged	Forged
Dimensions ...	11' x 6 1/2"	8 1/2' - 4 1/4"	11' x 2 1/4"
Progress on Inspection	—	—	—
Date when Inspected	Forged & Smithed July 3 <sup>rd</sup> to April 1/98	Forged & Smithed July 3 <sup>rd</sup> to May 26/98	Forged July 4/98

SKETCHES OF FRAMES SHOWING POSITION AND DESCRIPTION OF WELDS OF FORGINGS, OR PARTICULARS OF  
 TESTS APPLIED TO CASTINGS.

>  
 Weld

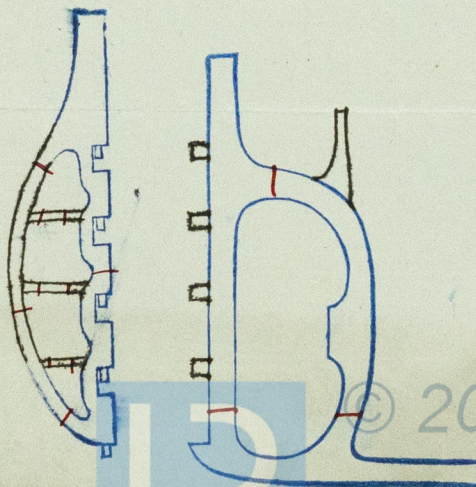

Fee (if any chargeable) £ : :

To be paid at