



14.98

18" S C A L E


BRIDGE 76'-0"

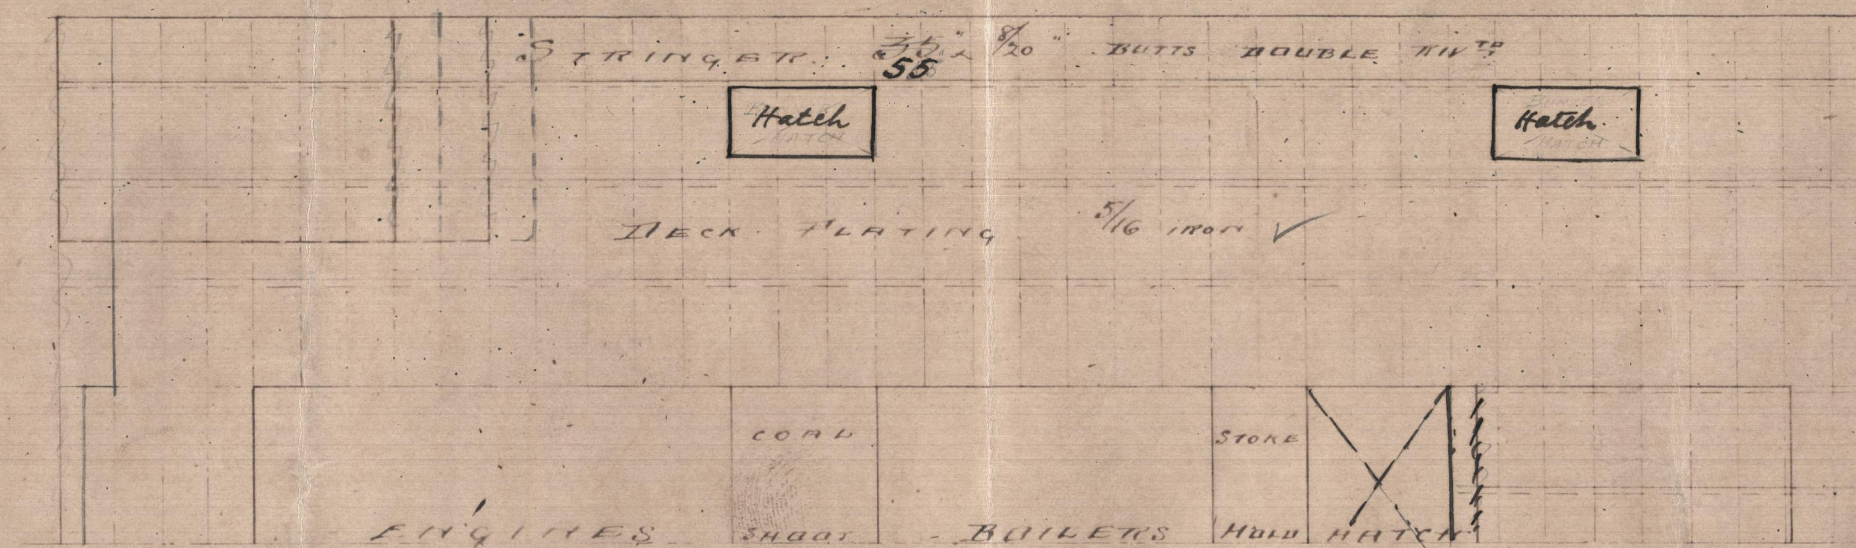

BRIDGE NECK

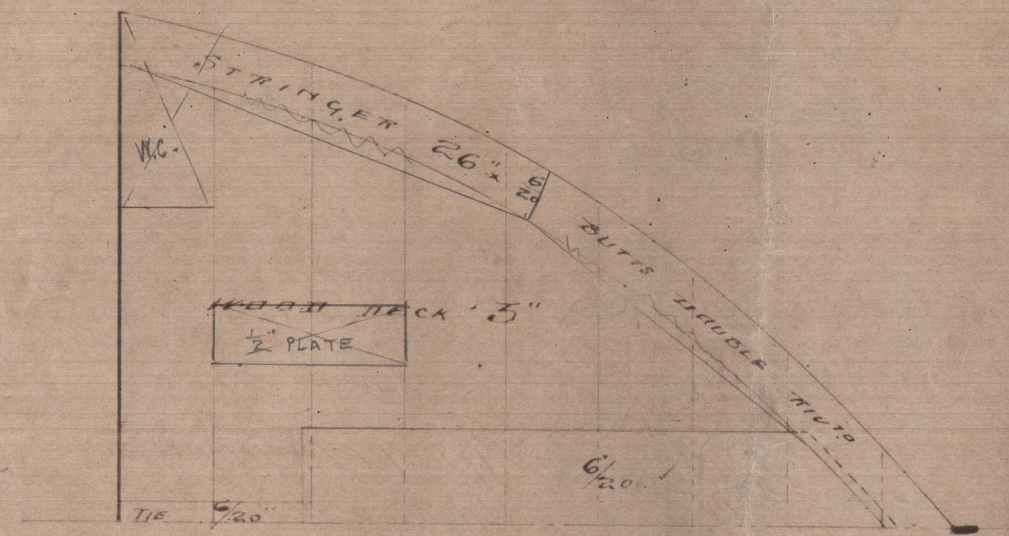

FORECASTLE DECK

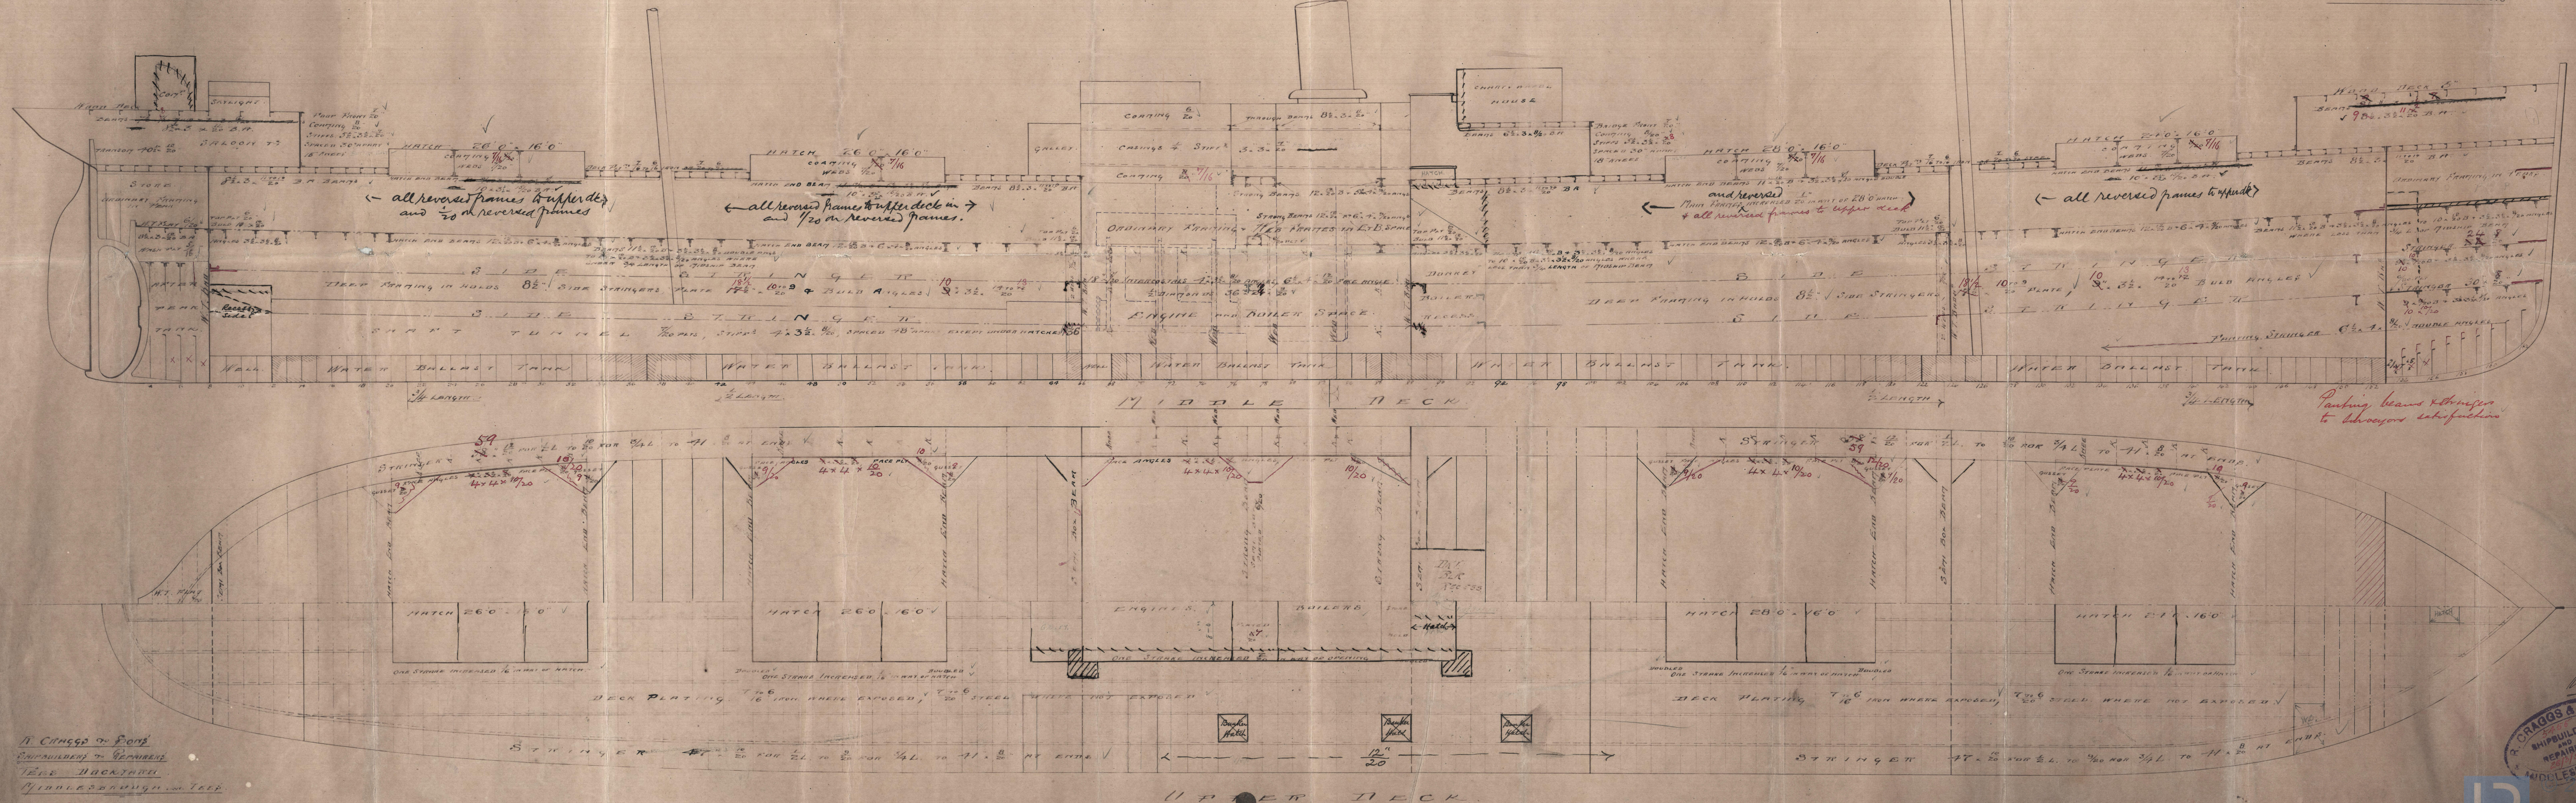

Panting beams & strainers  
to surveyors satisfaction ✓


11 PETER DECK

A circular ink stamp from R. CRAGGS &amp; SONS, SHIPBUILDERS AND REPAIRERS. The stamp is tilted. In the center, the number '5456' is handwritten in red ink. Below the number, the date '26/1/50' is handwritten in red ink. The text 'R. CRAGGS &amp; SONS' is at the top, 'SHIPBUILDERS' is in the middle, and 'AND REPAIRERS.' is at the bottom. The words 'BROUGH' and 'DON' are partially visible on the right side of the stamp.

*N<sup>o</sup> 48.*

L.D.  
11/4/98





R. Craggs & Sons  
No 148

Profile & deck plans

s/s "Broadgarth"

Report No 2499

MOB761-0023

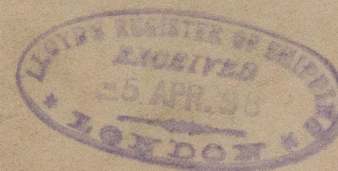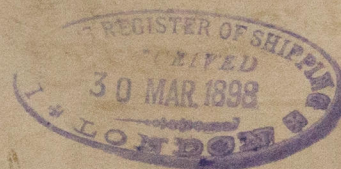

© 2020

Lloyd's Register  
Foundation