

of Broadgarth

Received at Middlesbro Office, 16<sup>th</sup> Nov<sup>r</sup> 1898

Lloyd's Register of British and Foreign Shipping.

(Report on Vessel No. 499 Port Middlesbro)

No. 4505 SHIP FORGINGS OR CASTINGS.

The words FORGINGS or CASTINGS, IRON or STEEL, should be struck out as may be required.

I have to report that the undermentioned Iron or Steel Forgings or Castings, manufactured by Messrs Hawthorn Leslie & Co of Hebburn for the Vessel No. 148, being built by Messrs R Briggs & Sons of Stockton have been inspected by me as set forth below, and found to be, so far as can be seen, sound



Mark on Forgings.

Lloyd's No. 7817B

John C Craig Newcastle

Table with 4 columns: Material\*, How made, Dimensions, Progress on Inspection, Date when Inspected. Rows for STERN FRAME, RUDDER FRAME, and STEM.

SKETCHES OF FRAMES SHOWING POSITION AND DESCRIPTION OF WELDS OF FORGINGS, OR PARTICULARS OF TESTS APPLIED TO CASTINGS.

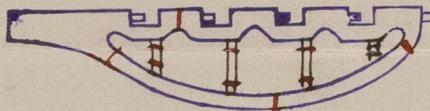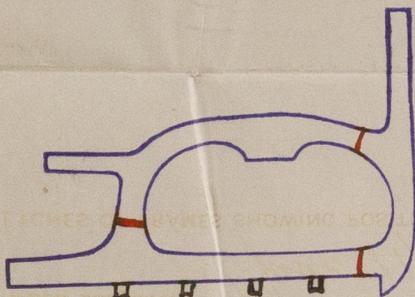

Welds

Fee (if any chargeable) £ : :

To be paid at



© 2019

Lloyd's Register Foundation