


A. Craig & Sons
No 148
Mach plan
of "Broadgarth"
Report No 2499

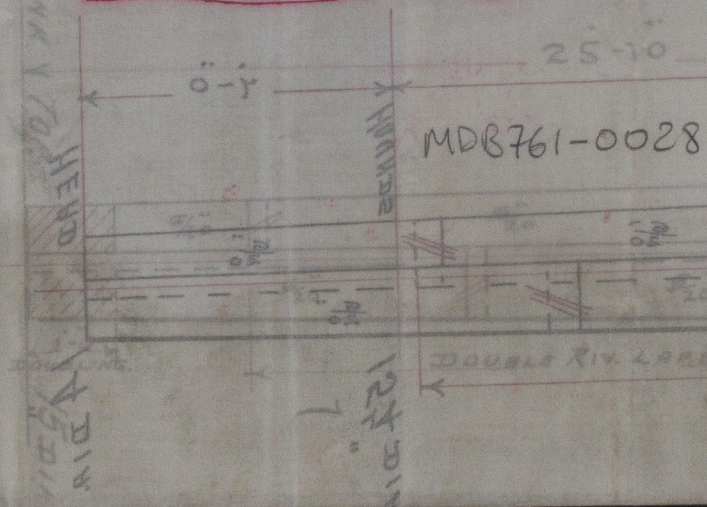

S.S. No 148
MAST PLAN.

MASTS TO CARRY FORE YARD

FORE MAST.

LENGTH UNDER

Deck

0'-00"




© 2020

Lloyd's Register
Foundation

MASTS TO CARRY FORE & AFT SAILS ONLY.

FORE MAST.


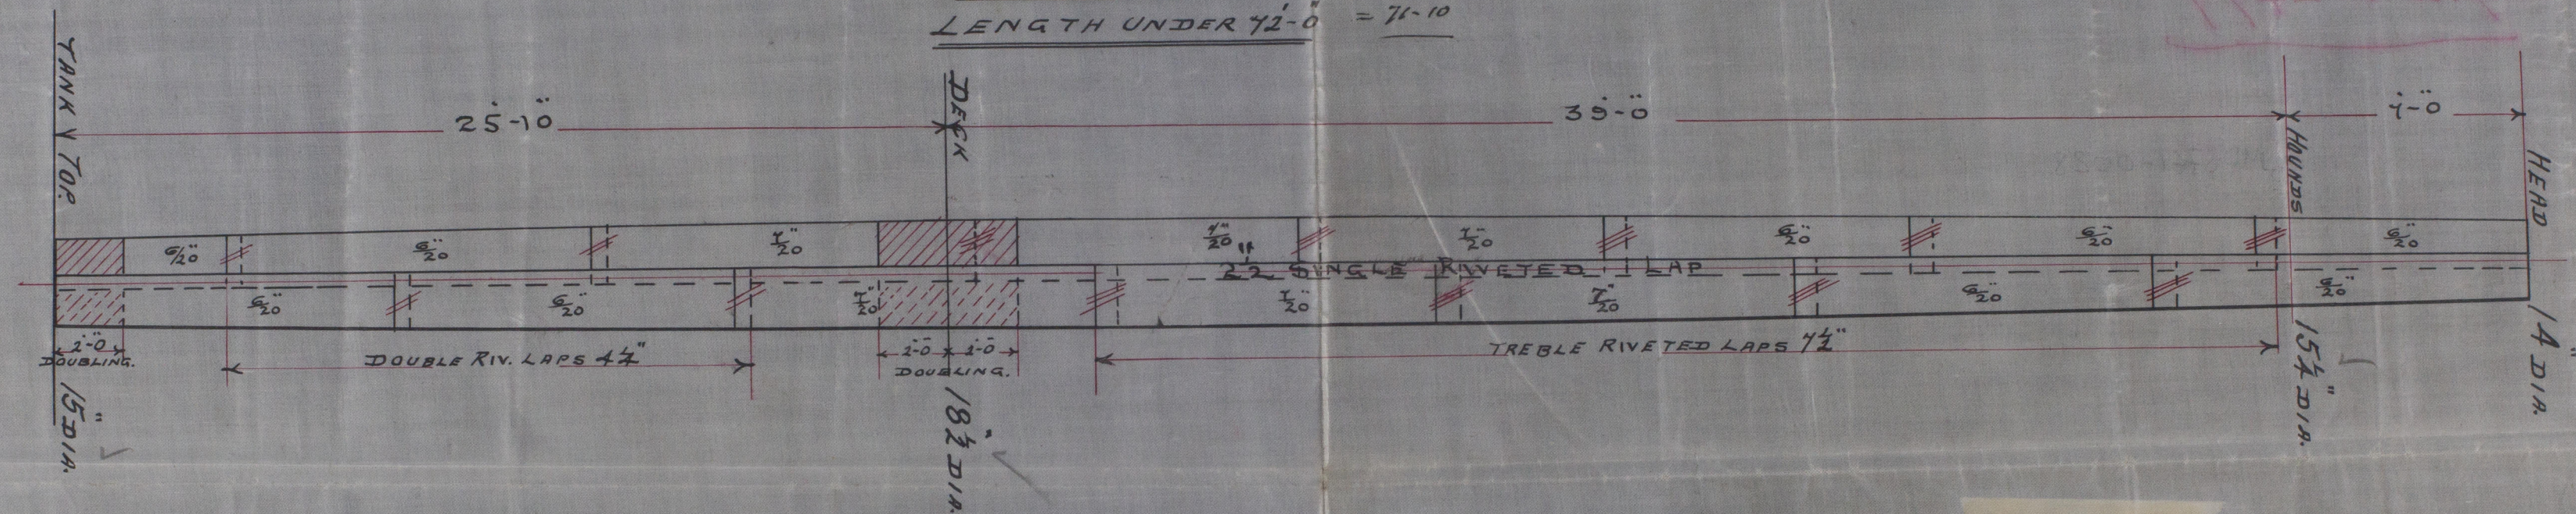

~~FORE~~ MAST

LENGTH UNDER 72'-0" *from tank top -*
= 71'-10"

