
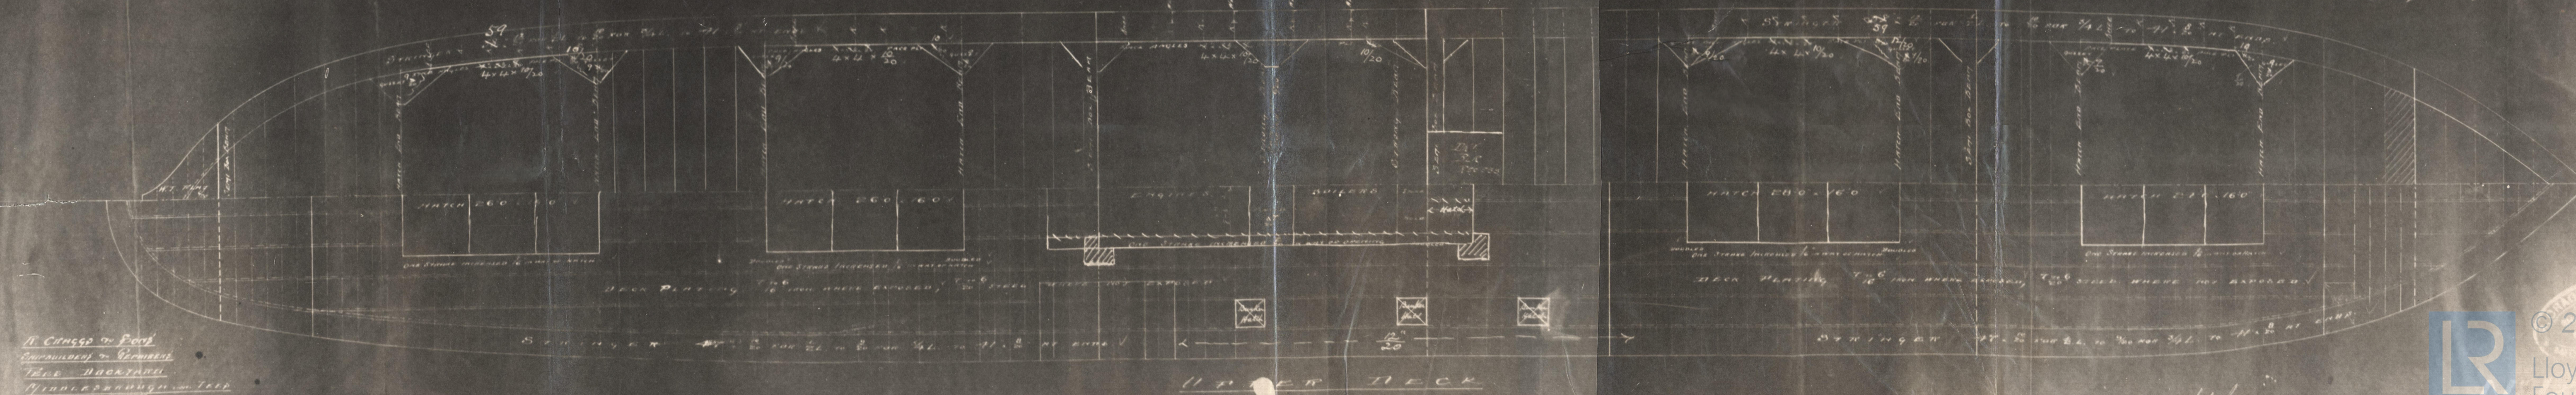
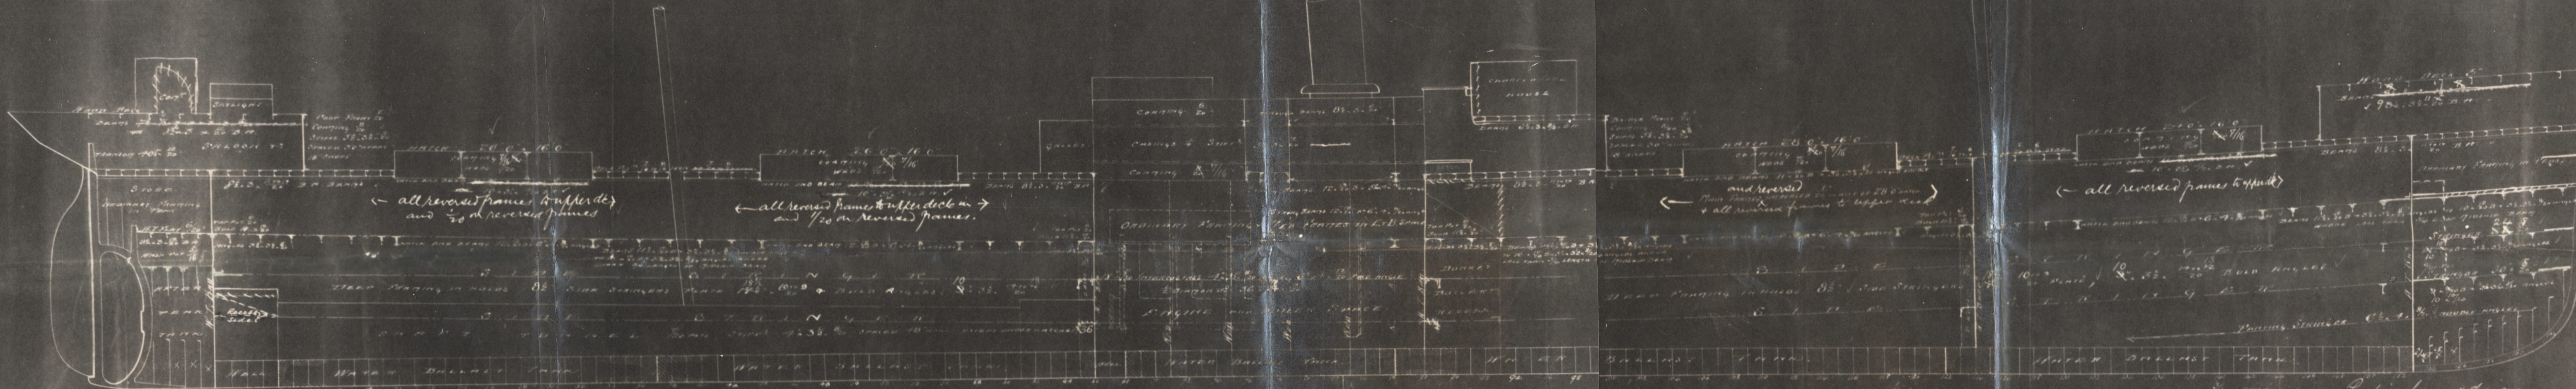
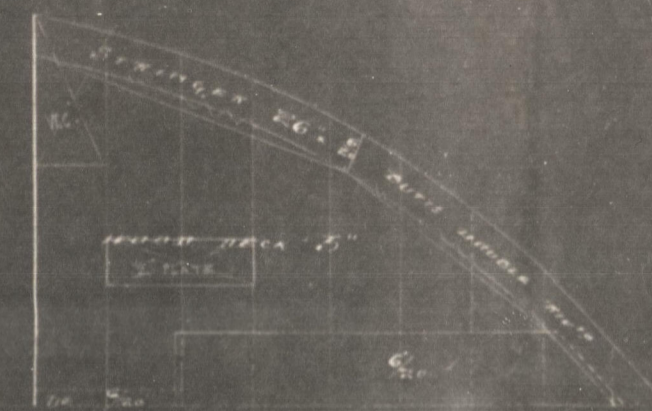
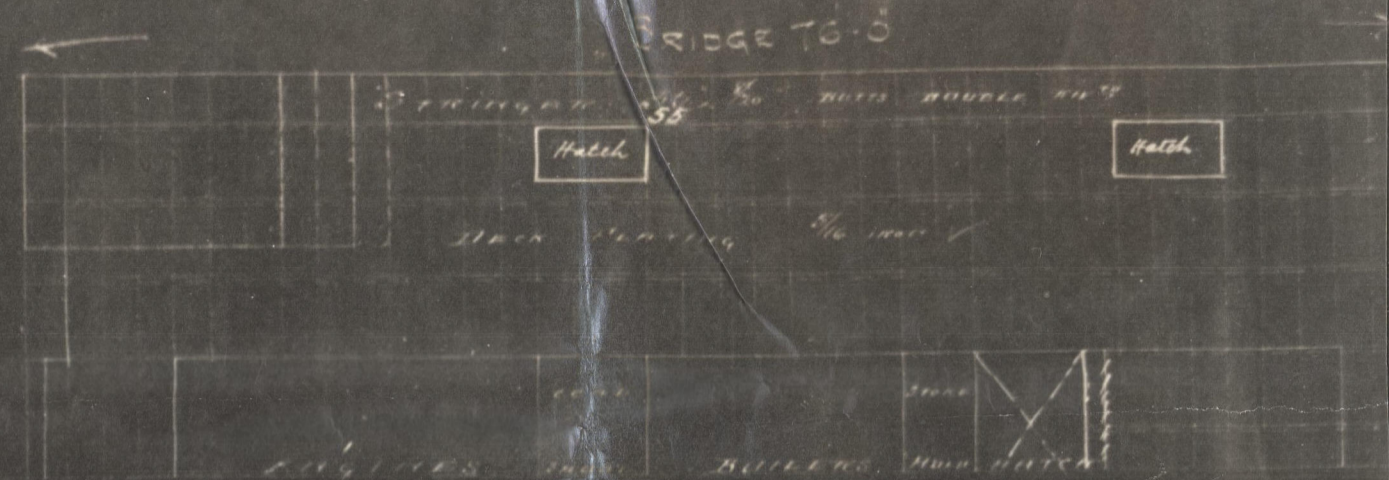


# PROFILE, DECK & STRINGER PLANS OF STEEL SCREEN STEAMER

Dimensions 330' 0" B.P. 17' 0" E.L. & 26' 6" M.H.

1/8" SCALE

14.98

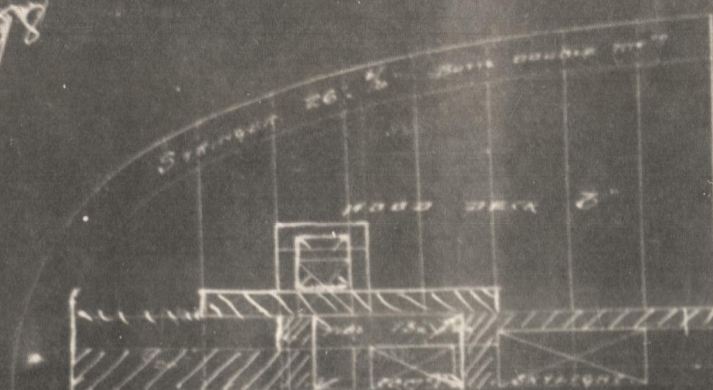




© 2020  
Lloyd's Register  
Foundation

MD8761-0033

Aghios Gerassimos


MD8761-0033



© 2020

Lloyd's Register  
Foundation