

H. Woodford

Received at Middlesbrough Office, 11th October 1898

Lloyd's Register of British and Foreign Shipping.

Middlesbrough (Report on Vessel No. 2535 Port Mdb)

No. 3577a

SHIP FORGINGS OR CASTINGS.

I have to report that the undermentioned Iron or Steel Forgings or Castings,
manufactured by Messrs. Wigham & Co.

of Stockton for the Vessel No. 355, being built

by Messrs. Roper & Son of Stockton

have been inspected by me as set forth below, and found to be, so far as can be seen,

sound

Mark on Forgings.

Lloyd's

No. 3577a

No. 6



W. J. Cameron

Sunderland

10. 10. 98

	STERN FRAME.	RUDDER FRAME.	STEM.
Material*	Scrap	/	Scrap
How made	Forged		Forged
Dimensions	11" x 6"		11" x 2 5/8"
Progress on Inspection	Forged & milled		Forged
Date when Inspected	from 15 th to 20 th 9/98		18 th 24/98

SKETCHES OF FRAMES SHOWING POSITION AND DESCRIPTION OF WELDS OF FORGINGS, OR PARTICULARS OF TESTS APPLIED TO CASTINGS.

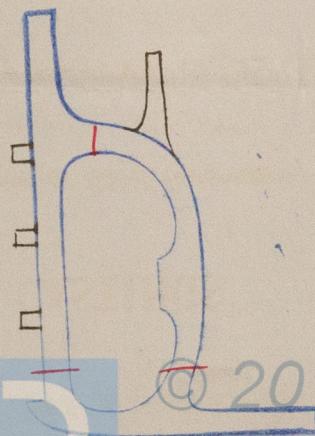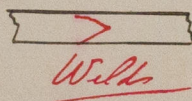

Fee (if any chargeable) £ : :

To be paid at



© 2019

Lloyd's Register
Foundation