

*J/s Bardsey*

Received at *Middlesbro* Office. *12<sup>th</sup> January 1899*

Lloyd's Register of British and Foreign Shipping.

(Report on Vessel No. *2541* Port *Mdb*)

*Middlesbro*

No. *3883.a* SHIP FORGINGS OR CASTINGS.

I have to report that the undermentioned Iron or Steel Forgings or Castings, manufactured by *Wm Wood & Co.* of *Stockton* for the Vessel No. *501*, being built by *Wm Richardson Dock Co.* of *Stockton* have been inspected by me as set forth below, and found to be, so far as can be seen, *sound.*

The words FORGINGS or CASTINGS, IRON or STEEL, should be struck out as may be required.



Mark on Forgings.

Lloyd's  
No. *3883.a*  
*No. 6*

*Rufus Cameron*  
*Sunderland*  
*10.1.99*

	STERN FRAME.	RUDDER FRAME.	STEM.
Material* ... ..	<i>Scrap</i>	<i>Scrap</i>	<i>Scrap</i>
How made ... ..	<i>Forged</i>	<i>Forged</i>	<i>Forged</i>
Dimensions ... ..	<i>11" x 6 1/2"</i>	<i>9" x 4 1/2"</i>	<i>11" x 2 3/4"</i>
Progress on Inspection	<i>Forged Smithed</i>	<i>Forged Smithed</i>	<i>Forged</i>
Date when Inspected	<i>June 15<sup>th</sup> to Sept 29/98</i>	<i>Oct 4/98 to Jan 5/99</i>	<i>Sept 16/98</i>

SKETCHES OF FRAMES SHOWING POSITION AND DESCRIPTION OF WELDS OF FORGINGS, OR PARTICULARS OF TESTS APPLIED TO CASTINGS.

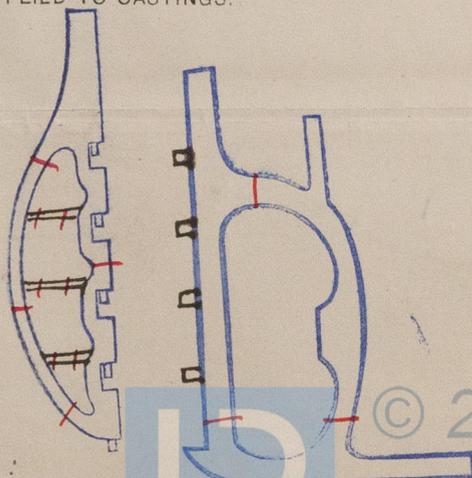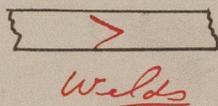

Fee (if any chargeable) £

To be paid at

