

BLAIR & COY., LTD
ENGINEERS,
1 OCT. 98
STOCKTON-ON-TEES.

after Hold

Fore after Hold

Pumping Arrangement

Scale $\frac{1}{8} = 1$ Foot

G & B. Space

Main Field

Fore Hold

- deck pump

Water Ballast
Tank

In lieu of hand pumps to bilges of holds a flywheel pump fitted on deck, connected to the main bilge suction pipe — with $3\frac{1}{2}"$ pipes

after Janse

Fore after Janse

Engine Janse

Maire Jank

Fore Vans

Fore & aft peak tanks pumped
up through Suction pipe

Air & sounding pipes to be filled

H.S.
4.10.98





Lloyd's Register
Foundation

MD8761-0161


MESSRS RICHARDSON, DUCK & CO

— SHIPBUILDERS

STOCKTON-ON-TEES

Underdeck Tonnage about 3200 Tons

Sept 29th 1898

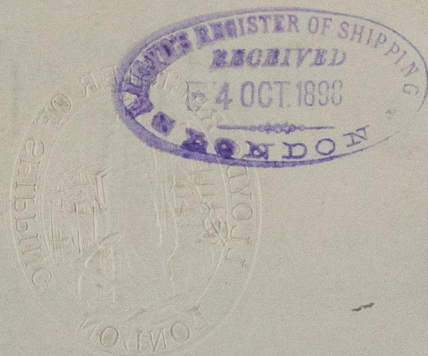

Pumping Plan
Richardson Duck Vce

no 507

S.S. "Bardsey"

Abro Report - no 2541

S.S. "Clinton"

Abro Report - no 2564

MOB761-0161



© 2020

Lloyd's Register
Foundation