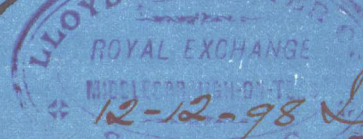


Mr. 12. 98.  
14.

{ In lieu of hand pumps to bilges of holds  
a fly wheel pump fitted on deck <sup>light not to exceed 24 ft.</sup> connected  
to the main bilge suction pipe. 5 pipes.

air & sounding pipes to be fitted

— MESSRS RICHARDSON, DUCK & CO —  
— SHIPBUILDERS —  
— STOCKTON-ON-TEES. — Underdeck Stowage about 2370 tons —

*PS*  
*12.12.98.*  
  
*12.12.98*

© 2021  
No. 503  
Lloyd's Register  
Foundation  
MD8762-0080




Pumping Plan.

Richardson Duck & Co

No 503.

S.S. "Hovington"

Intro Report - No 2589.

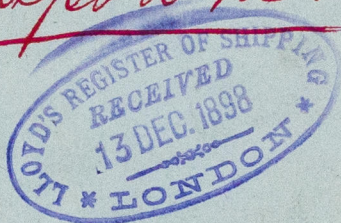

MD8762-0080



© 2021

Lloyd's Register  
Foundation