


DIMENSIONS

LENGTH P P 360'-0"
 BREADTH M⁰ 48'-0"
 DEPTH M⁰ TO MAINDECK 22'-11 1/2"
 DEPTH M⁰ TO SPARK 30'-11"

S.S. N° 63.

MIDSHIP SECTION.


SCALE 1/4" = 1 FOOT

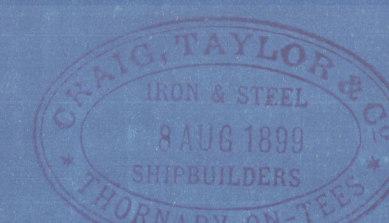

NUMERALS.

1/2 BEAM 24'-0"
 1/2 GIRTH 14'-0"
 DEPTH 23'-9 1/2"
 FRAME NO. 92-00
 358.16 x 92.00 = 32951 PLATING N° 317/33400
 1/8 14'-9 1/2"
 1/8 7'-4 1/2"

EQUIPMENT N° TO SPAN DECK = 38649
 POOP 30 FT
 BRIDGE 90
 ECL 36
 150
 35816
 21014-150
 EQUIPMENT N° (34000/13600) (2)

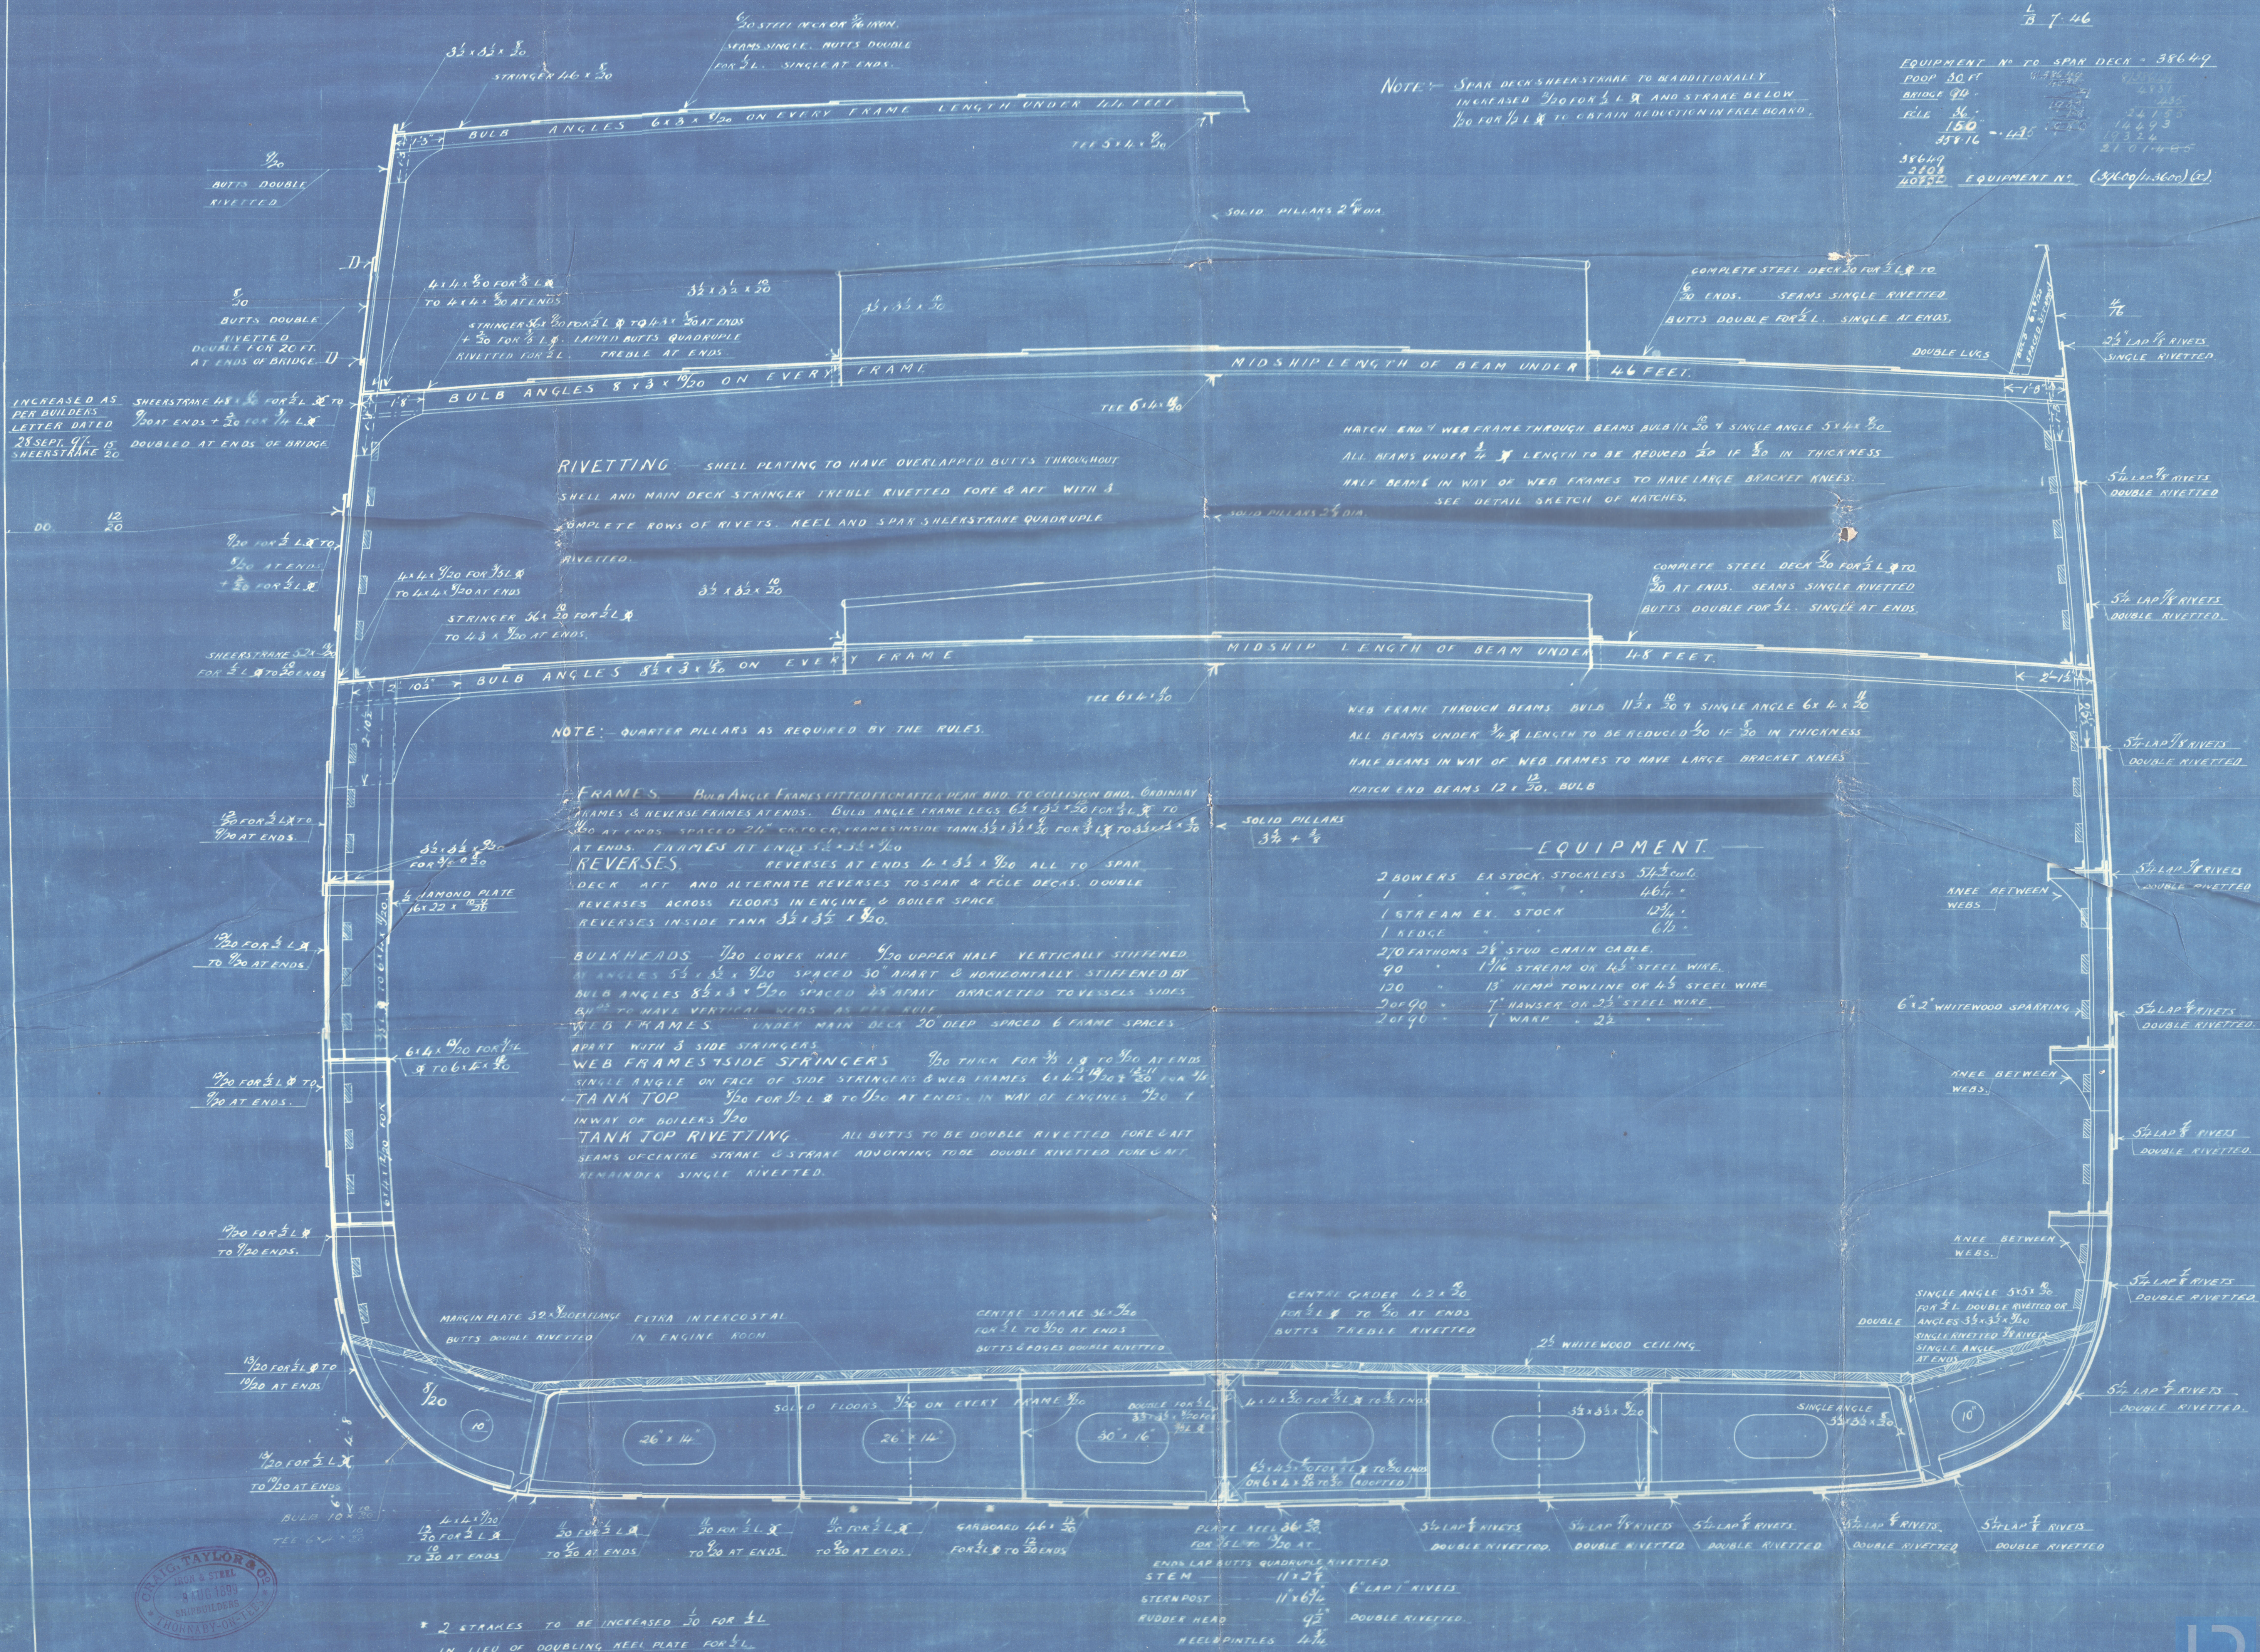

Midship Section

Craig Taylor & Co.

No 63

(Duplicate of 56154)

S.S. "Orinley"

Intro Report No 2668.



sister vessel to

S.S. Sylviana

Mat 7321

S.S. Mayflower

Mat. 2476



© 2020

Lloyd's Register
Foundation

MOB 763-0076