


PUMPING ARRANGEMENT.

2739 TONS UNDER DECK

SCALE 1/2" = 1 FOOT

Similar to plan approved for sister vessel at 1460 1/2 Mount Blanc
Mdb Report 2620- (Flywheel pump in lieu of hand pumps)
6-22/7/98

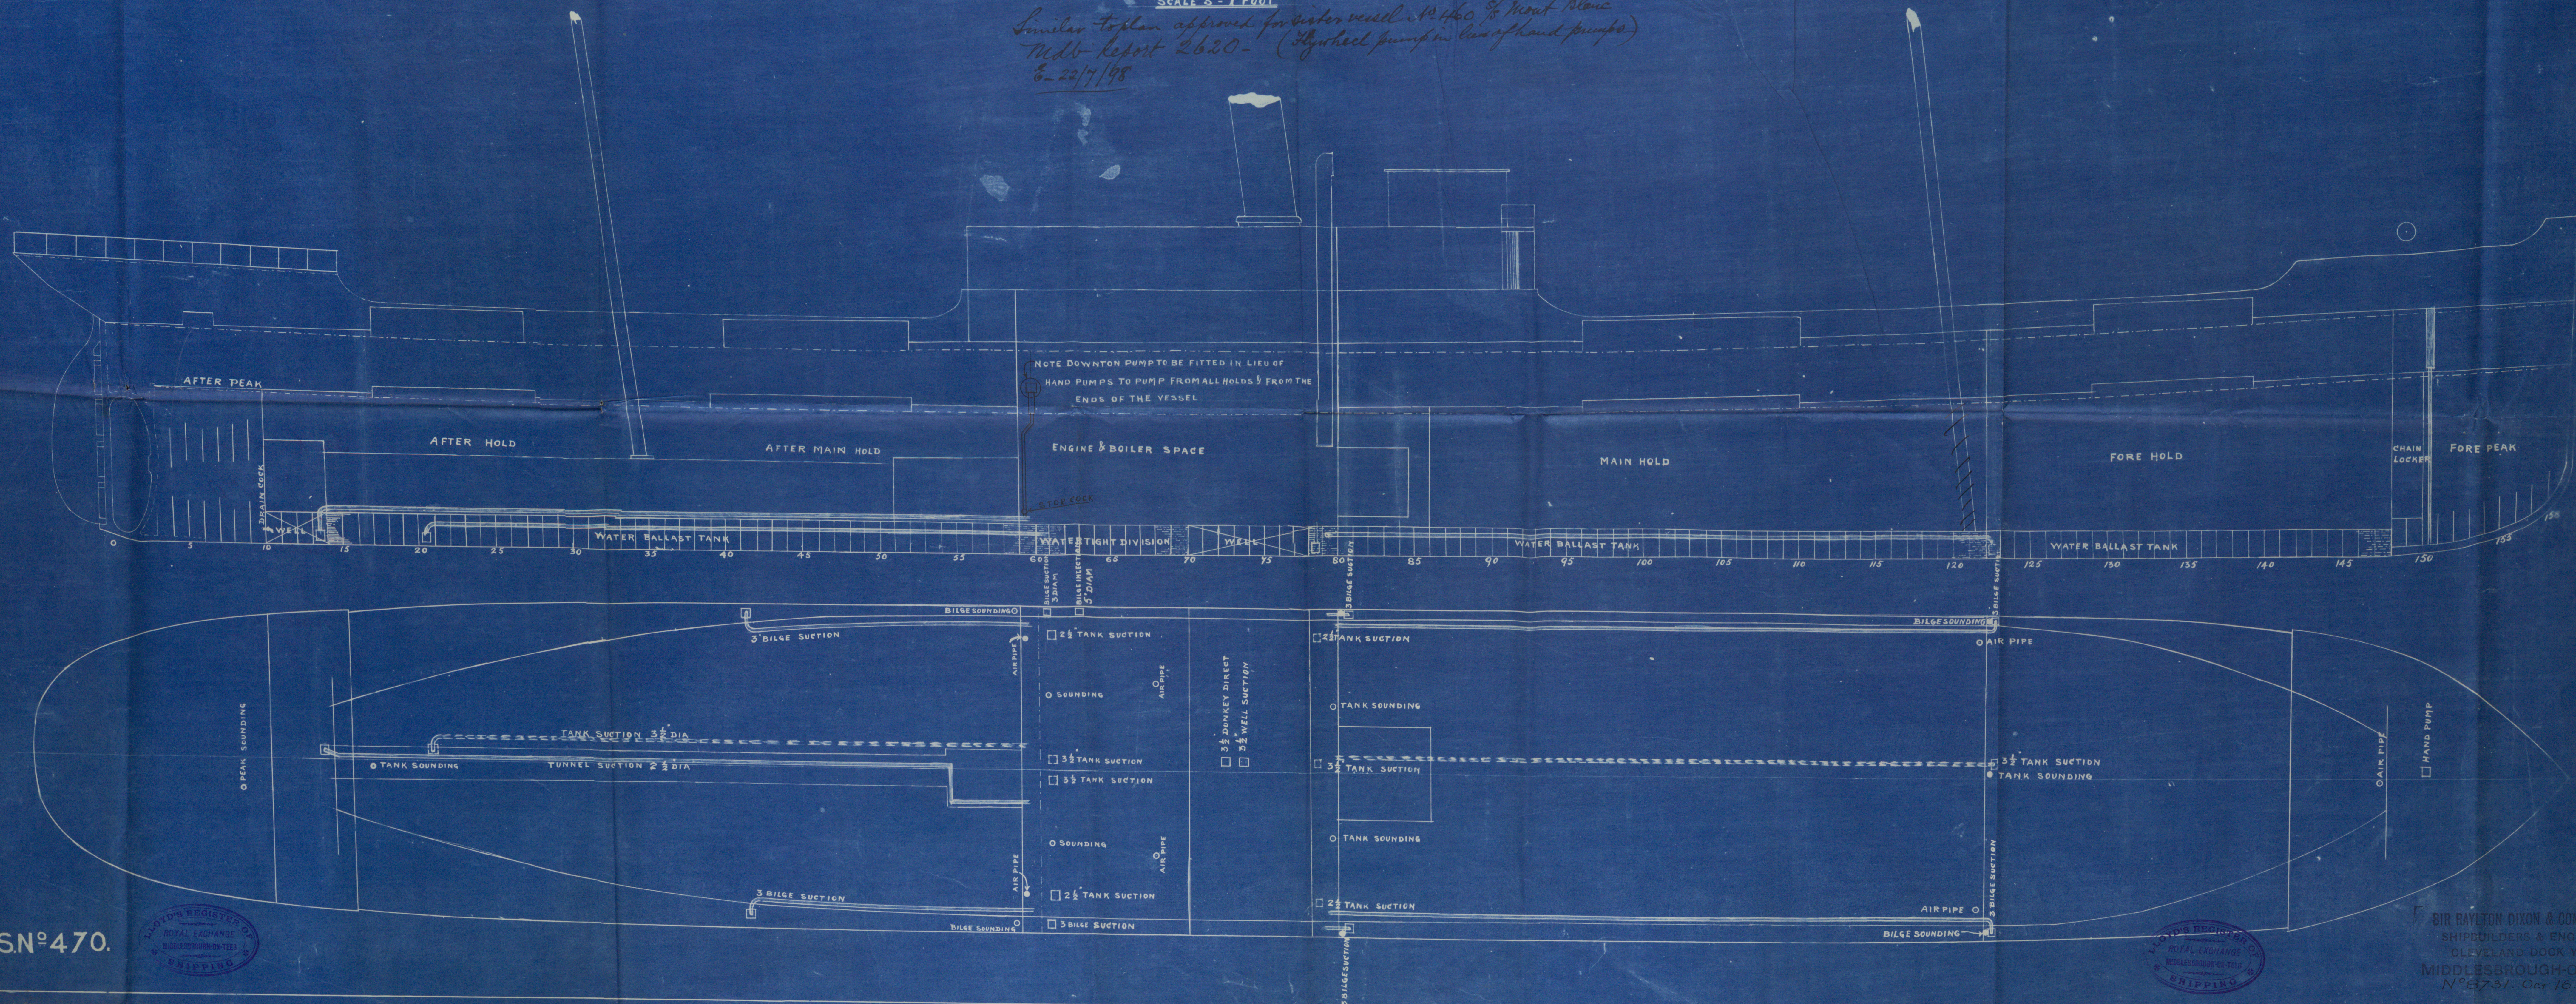

S.S.N°470.



SIR RAYLTON DIXON & COMPANY, L^{TS},
SHIPBUILDERS & ENGINEERS,
CLEVELAND DOCK YARDS,
MIDDLESBROUGH-ON-TEES.
N°6731, Oct 16, 99.

Sir R. Dixon & Co.

No 470

Pumping Plan

"Thaugape"

Mdb: Report No 2822.

Sister vessel to
S.S. Mont Blanc.
Ldb. 2620.



© 2019

Lloyd's Register
Foundation

MDB765-0075