




26.4.99

# FLANGED BULKHEADS

SCALE  $\frac{1}{4}" = 1 \text{ FOOT}$

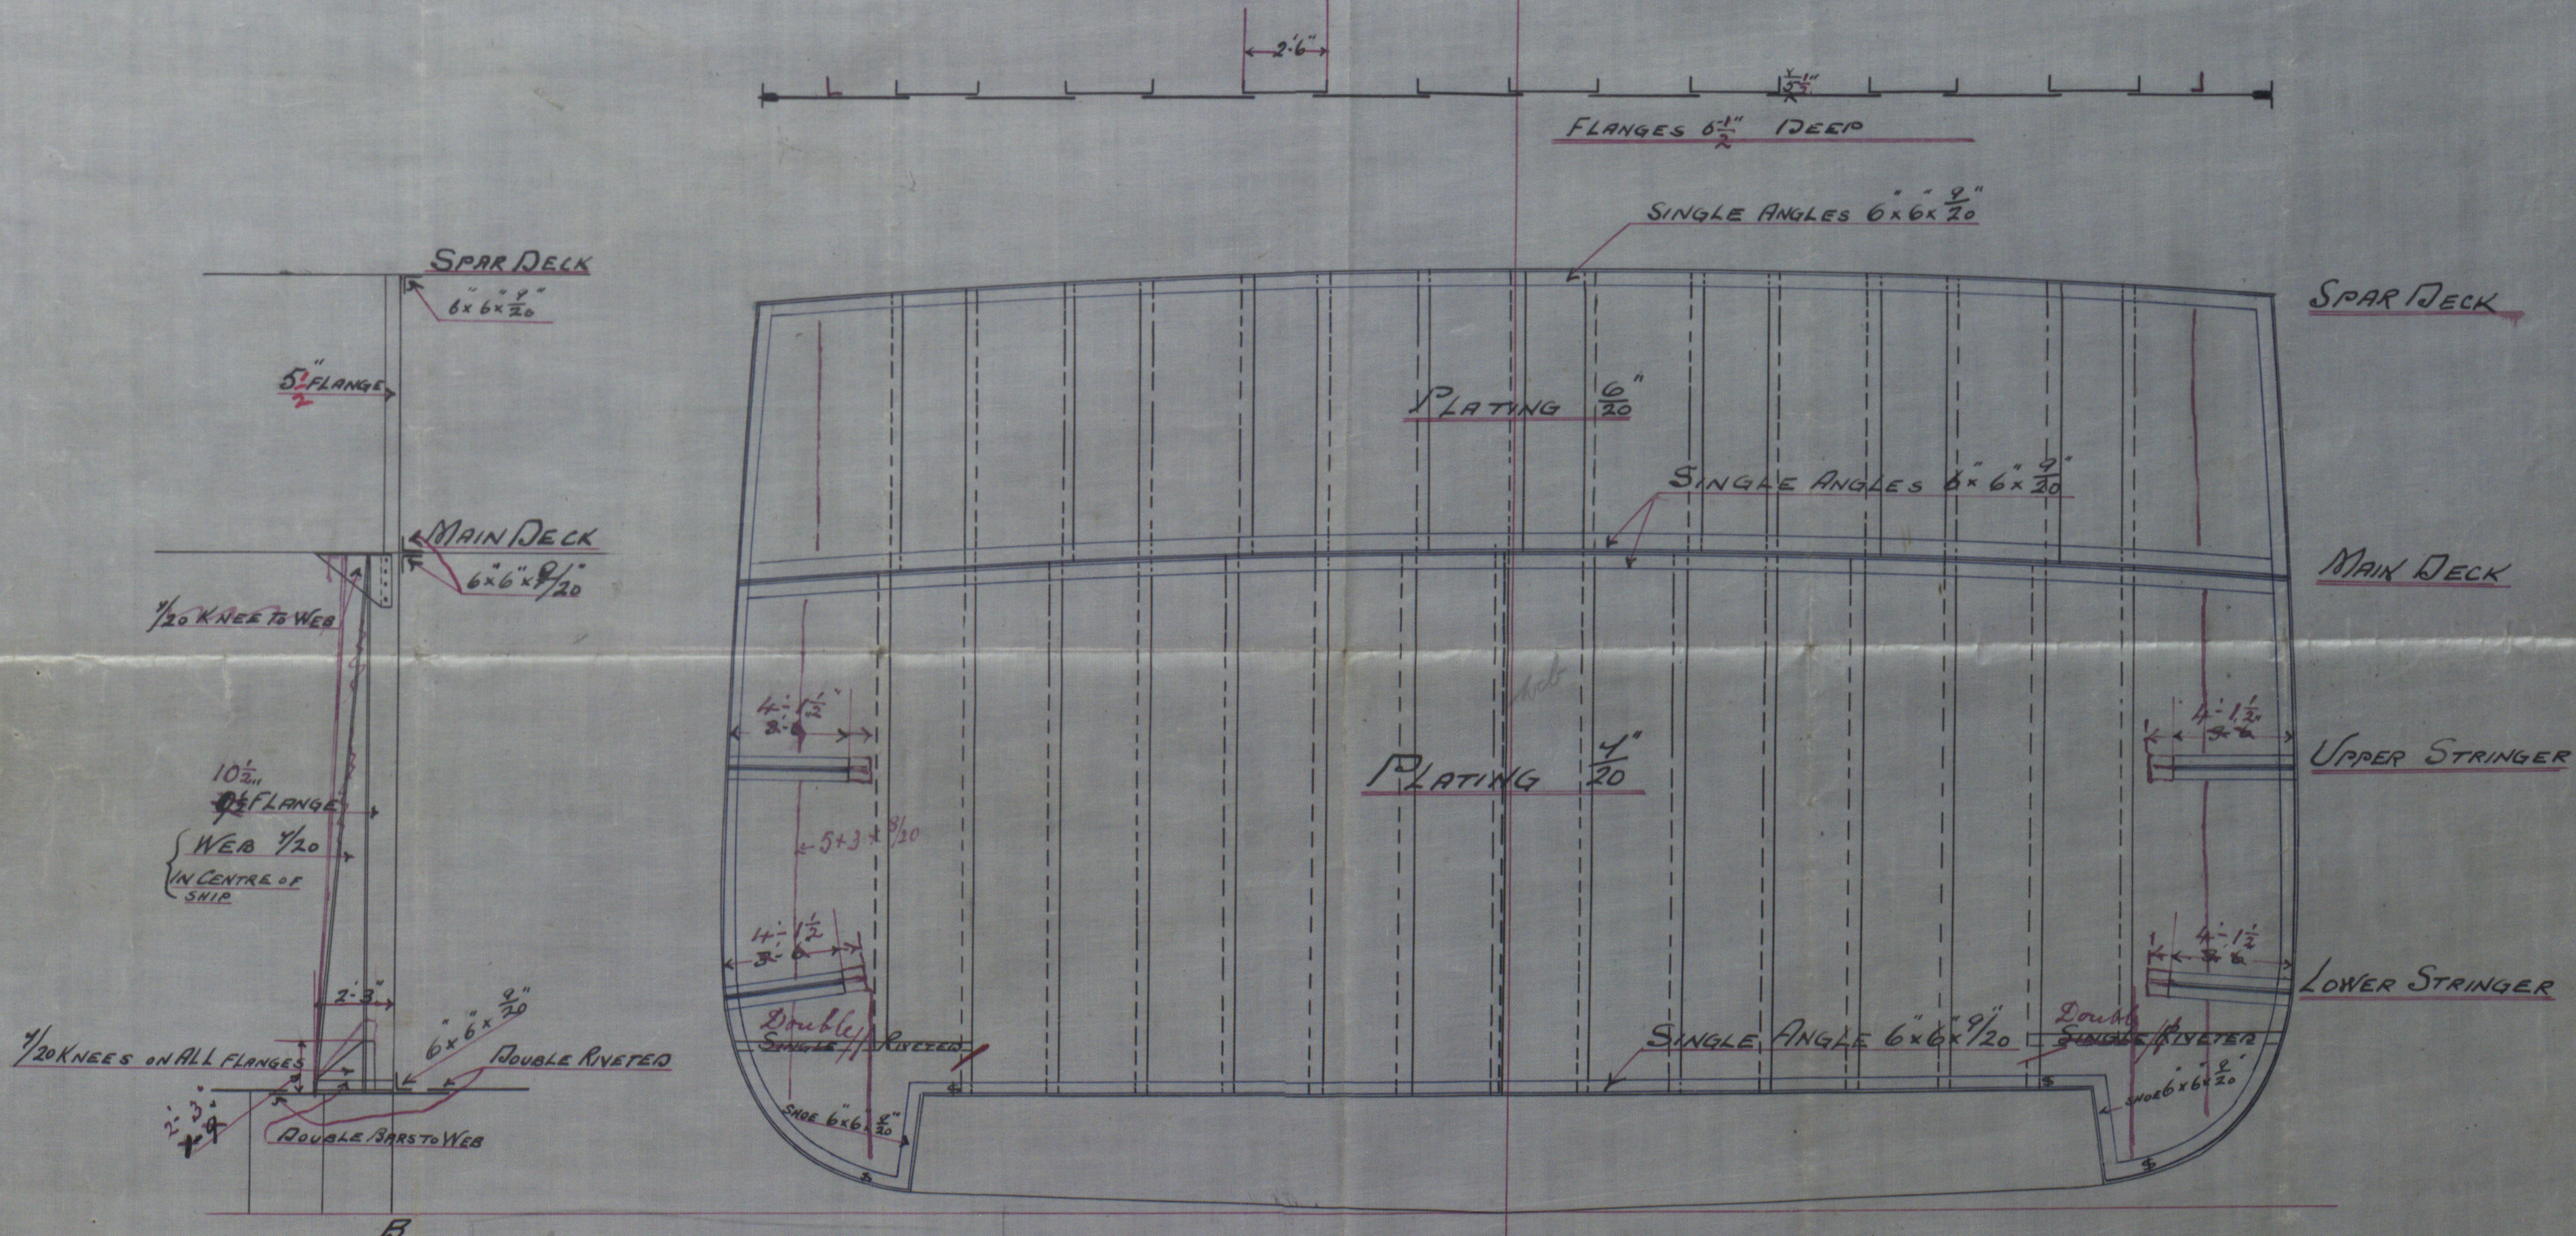


Rule Shipping  
 5x3x8/20 angles  
 8x3x11/20 B. angles  
 1 web  
 1 same boxbeam

## TANK TOP PLATING INWAY OF FLANGED BULKHEADS

SCALE  $\frac{1}{4}" = 1 \text{ FOOT}$

TANK TOP OF IRON

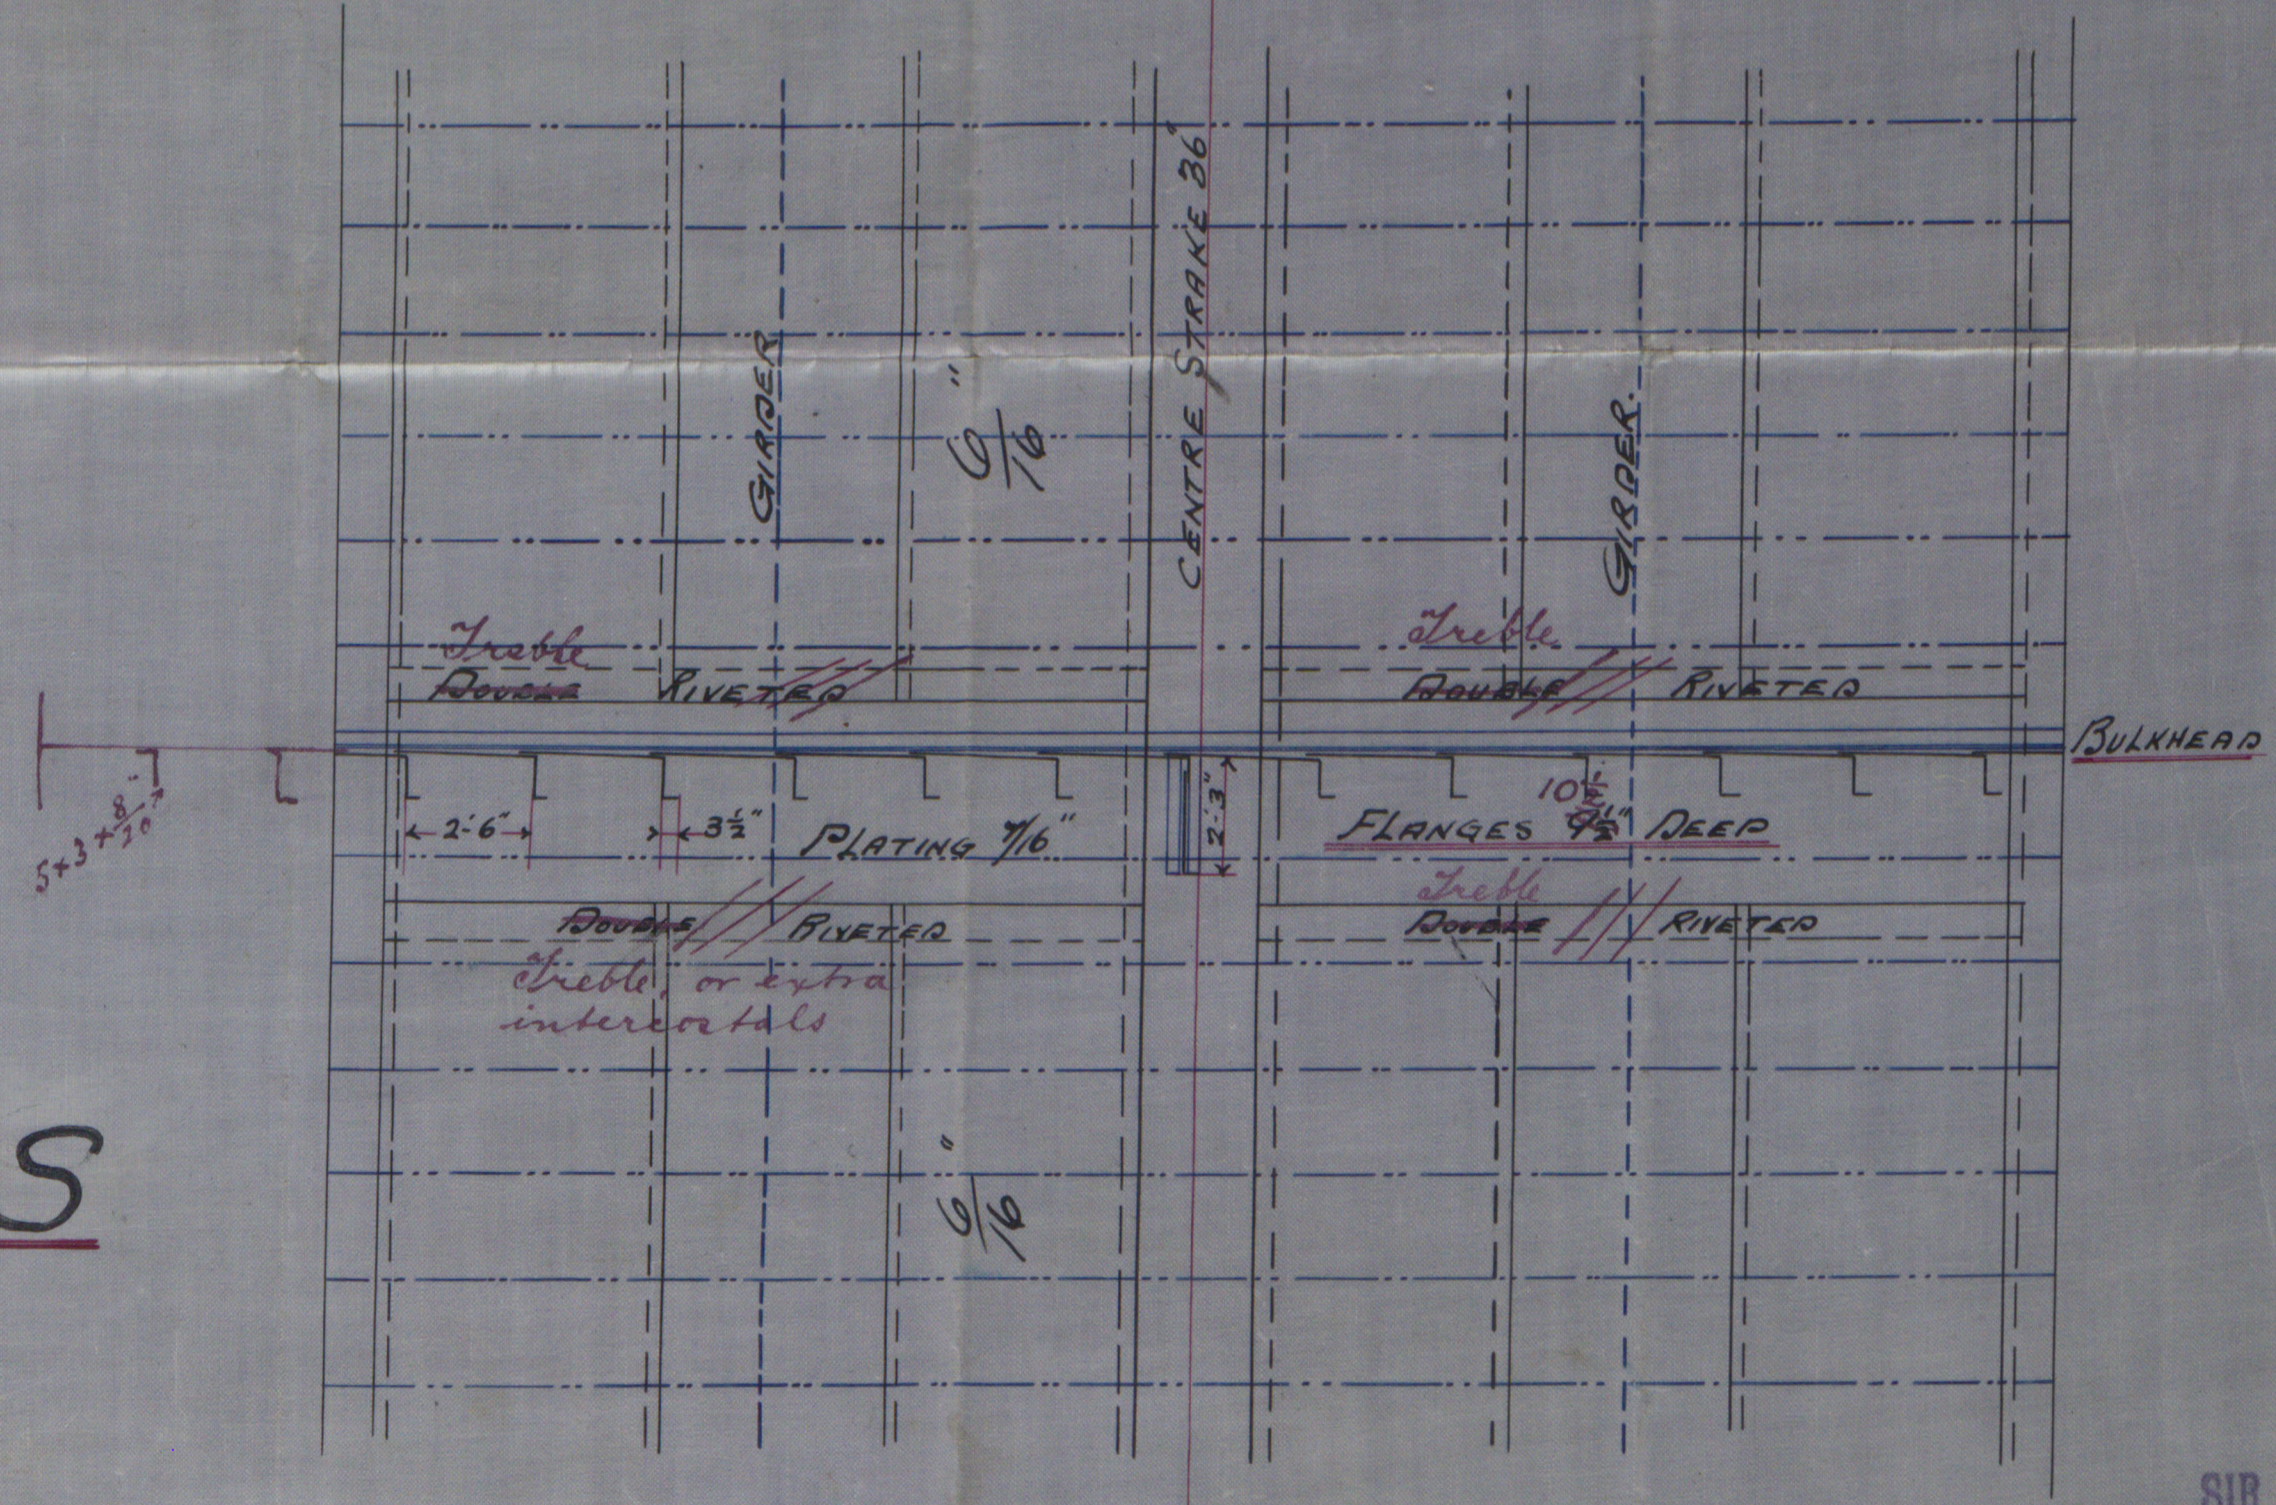

Nº 470.55

SIR RAYLTON DIXON & COMPANY, L<sup>td</sup>,  
 SHIPBUILDERS & ENGINEERS,  
 CLEVELAND DOCK YARDS,  
 MIDDLESBROUGH-ON-TEES.  
 TRACING No 6817 APRIL 19TH 1899

MD8765-0077

26/4/99

Sir R. Dixon & Co

No 470

Flanged BMS.  
Tank top plating  
at BMS.

"Whangape"

Mdb Report No 2822



© 2019

Lloyd's Register  
Foundation

MDB765-0077