


SKETCH SHEWING OPENINGS IN TANK
IN WAY OF BOILERS NO 470

SCALE 1/4" = 1 FOOT

NO 470

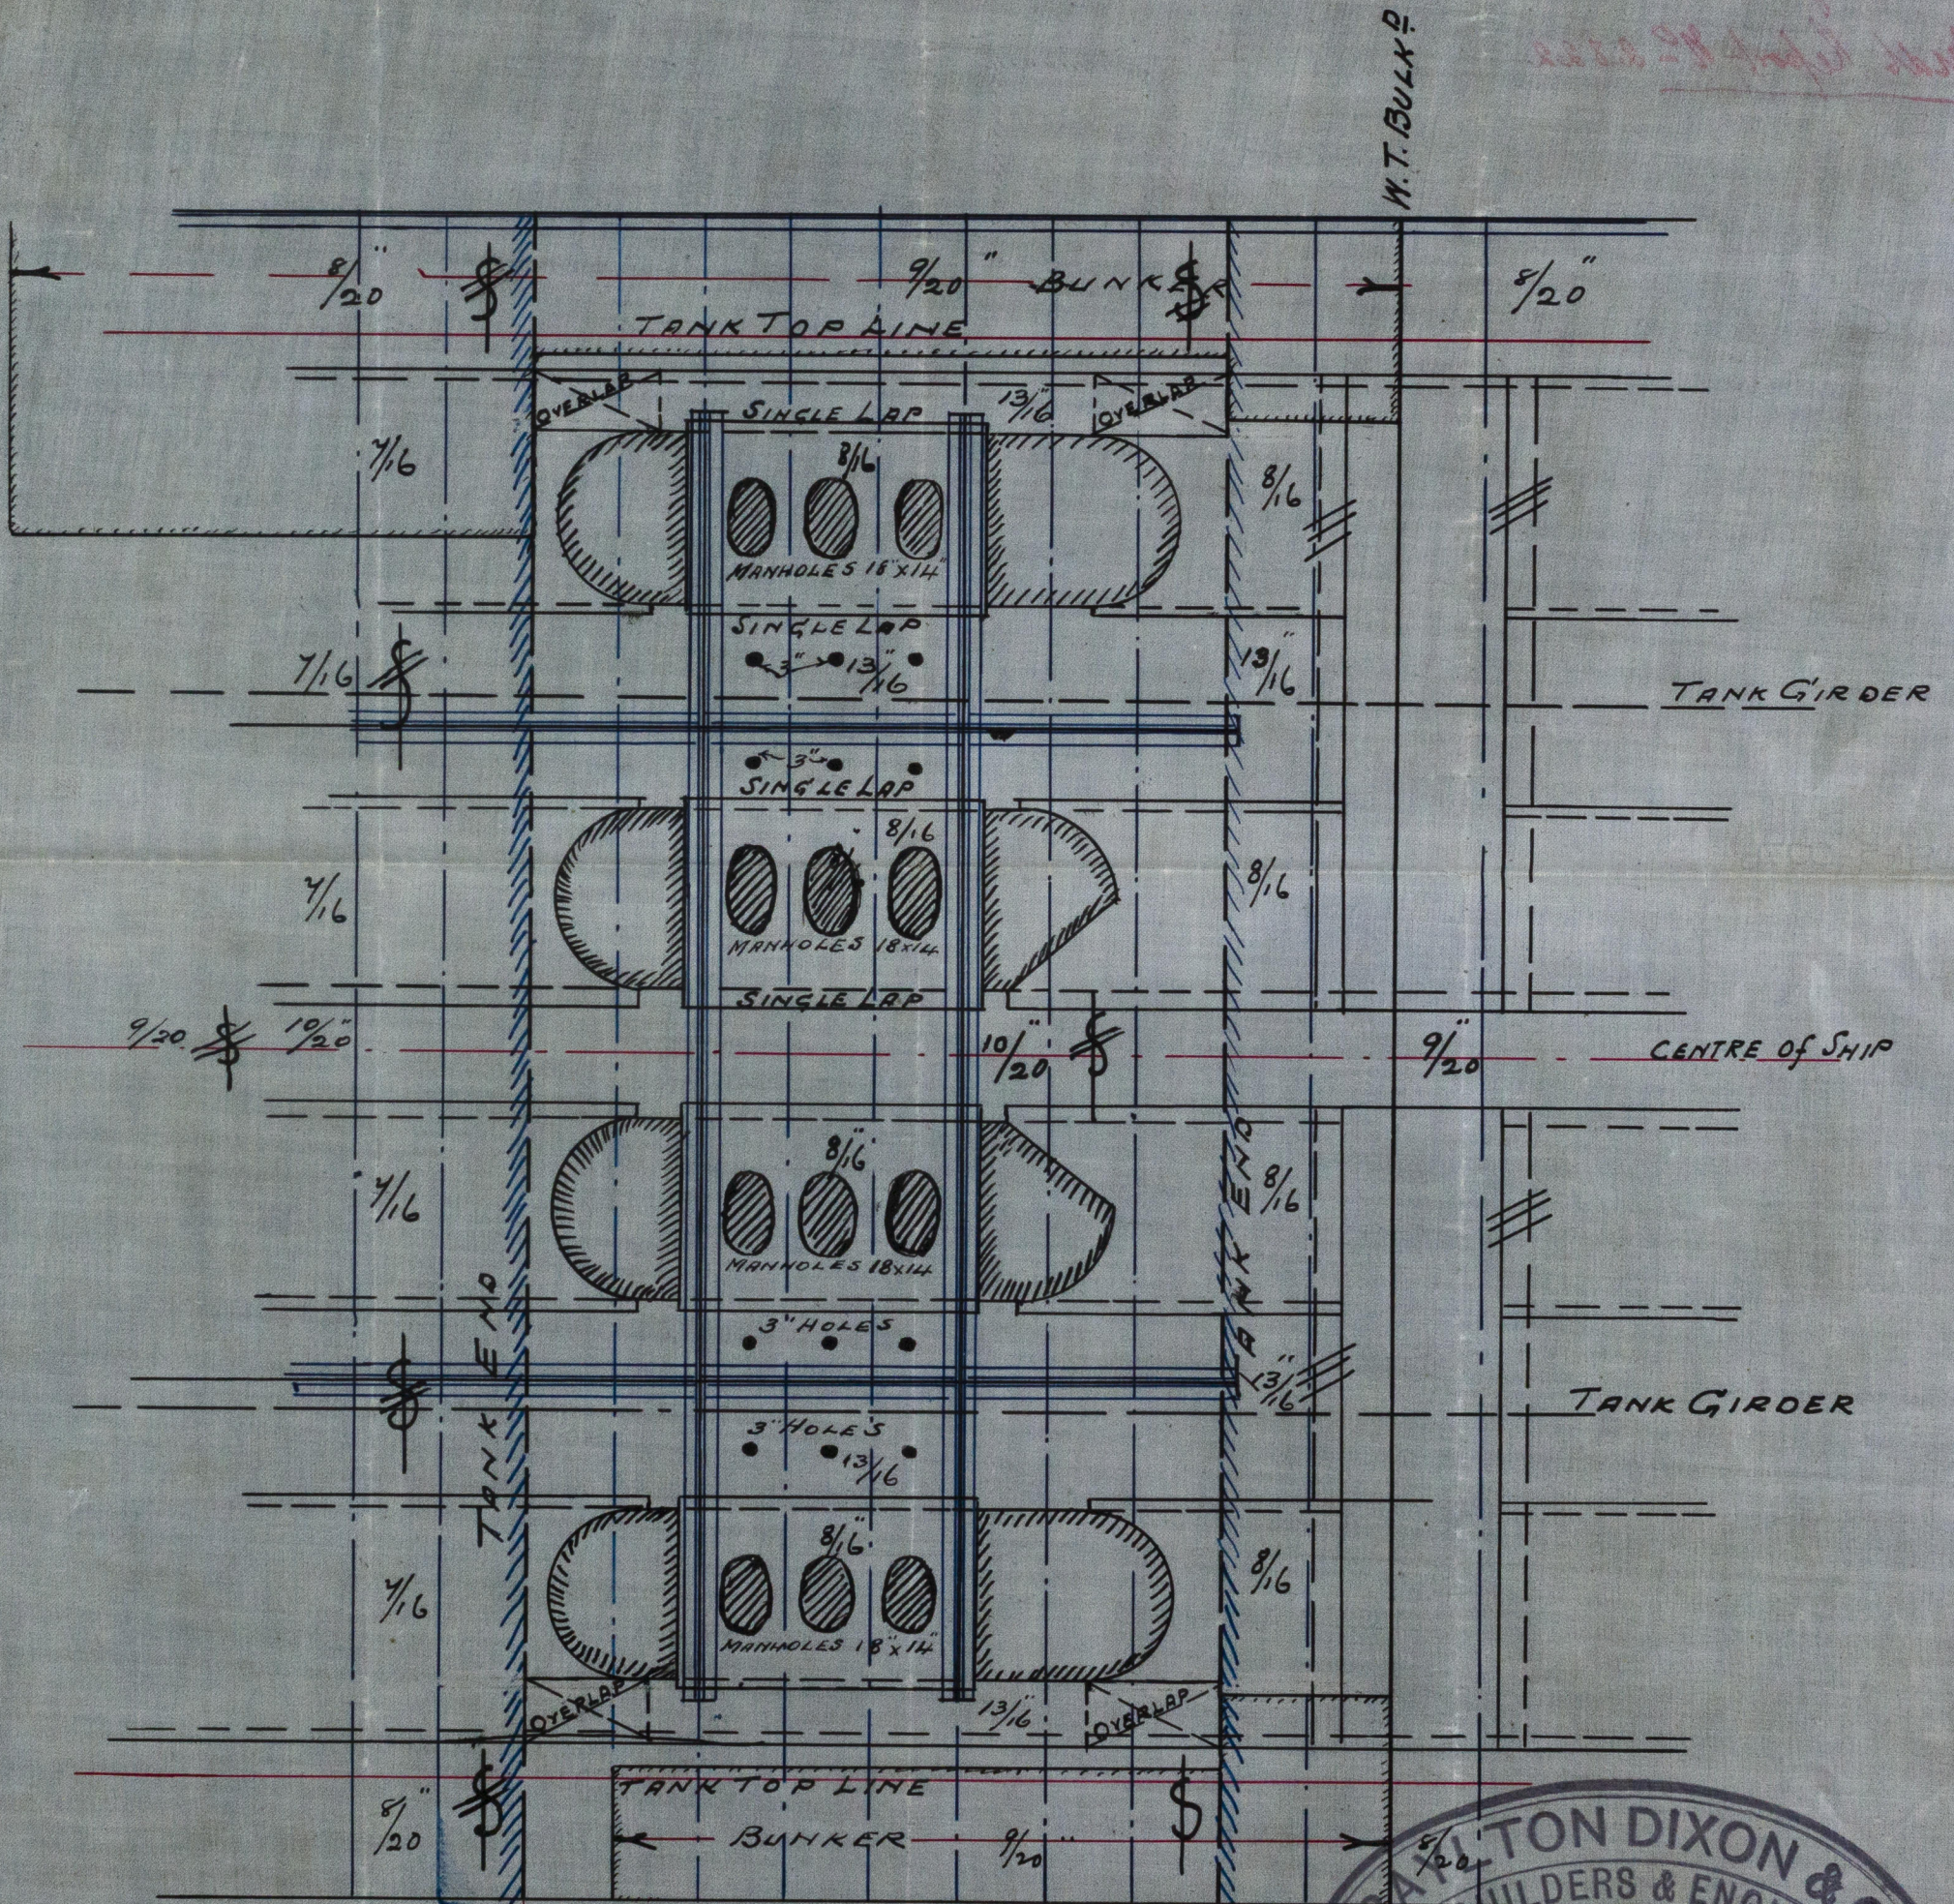

NO WATER BALLAST HERE
 Shell plating not to be reduced



Med. Report No 2822

Sketch showing openings in Tank
in Way of Bolters No 470
Scale 1" = 1 Foot

10/11/07

OF THE