

of *Uskehall*

Received at *Middlesbrough* Office. 19th April 1900

Lloyd's Register of British and Foreign Shipping.

Middlesbrough (Report on Vessel No. *2838* Port *Mdb*)

No. *4148a* and SHIP FORGINGS OR CASTINGS.

The words FORGINGS or CASTINGS, IRON or STEEL, should be struck out as may be required.

I have to report that the undermentioned Iron and Steel Forgings and Castings, manufactured by *the Darlington Forge Co* of *Darlington* for the Vessel No. *161*, being built by *Messrs R Craggs & Sons* of *Middlesbrough* have been inspected by me as set forth below, and found to be, so far as can be seen, *sound. Stern frame tested as required by the Rules and found satisfactory*

Mark on Forgings.

Lloyd's

No. *4148a*
No. 6.

Wugh Cameron


Sunderland
18/4/00,
STEM.

	STERN FRAME.	RUDDER FRAME.	STEM.
Material*	<i>Siemens Steel</i>	<i>Scrap Iron</i>	<i>Scrap Iron</i>
How made	<i>Cast</i>	<i>Forged</i>	<i>Forged</i>
Dimensions	<i>as per plan attached</i>	<i>9 1/2 - 14 3/4</i>	<i>11" x 2 7/8</i>
Progress on Inspection	<i>Cast tested</i>	<i>Forged & Smithed</i>	<i>Forged</i>
Date when Inspected	<i>June 15 - 21/99</i>	<i>Jan 5th to Feb 23/1900</i>	<i>July 8/99</i>

SKETCHES OF FRAMES SHOWING POSITION AND DESCRIPTION OF WELDS OF FORGINGS, OR PARTICULARS OF TESTS APPLIED TO CASTINGS.



Welds

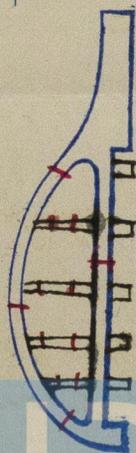

Fee (if any chargeable) £ : :

To be paid at

© 2019

Lloyd's Register Foundation