

24	3	99
10	6	99
15	1	00
31	3	00
18	7	00

LENGTH B.P. 360-0 BREADTH EX. 48-0 DEPTH MLD 30-10 TO SPAN D.K.

TO CLASS 100A.1 AT LLOYDS "SPAR DECK."

SCALE: $\frac{1}{2}$ " = ONE FOOT.

LLOYDS DIMENSIONS

LENGTH FROM AFTER SIDE OF STEM TO FORE SIDE OF STERNPOST 357'-7" on line of spar BK

BREADTH MOULDED 47' 9"

DEPTH TO SKIN ASSUMING $11\frac{1}{2}$ ROUND UP OF BEAM [TO MAIN DECK] 23-10

14.99 DEPTHS TO LENGTH [MAIN DECK]

NUMERALS

NUMERALS.
1/2 GIRTH. 43.27.


1/2 BREADTH 23.87

DEPTH 23.84

$$157 \text{ N}^{\circ} 90.98 \times 357.58 = 32532.62$$

SCANTLING GRADES 85-91 AND 31200-33900

EQUIPMENT NO. 40422 GRADES 39600-43600.

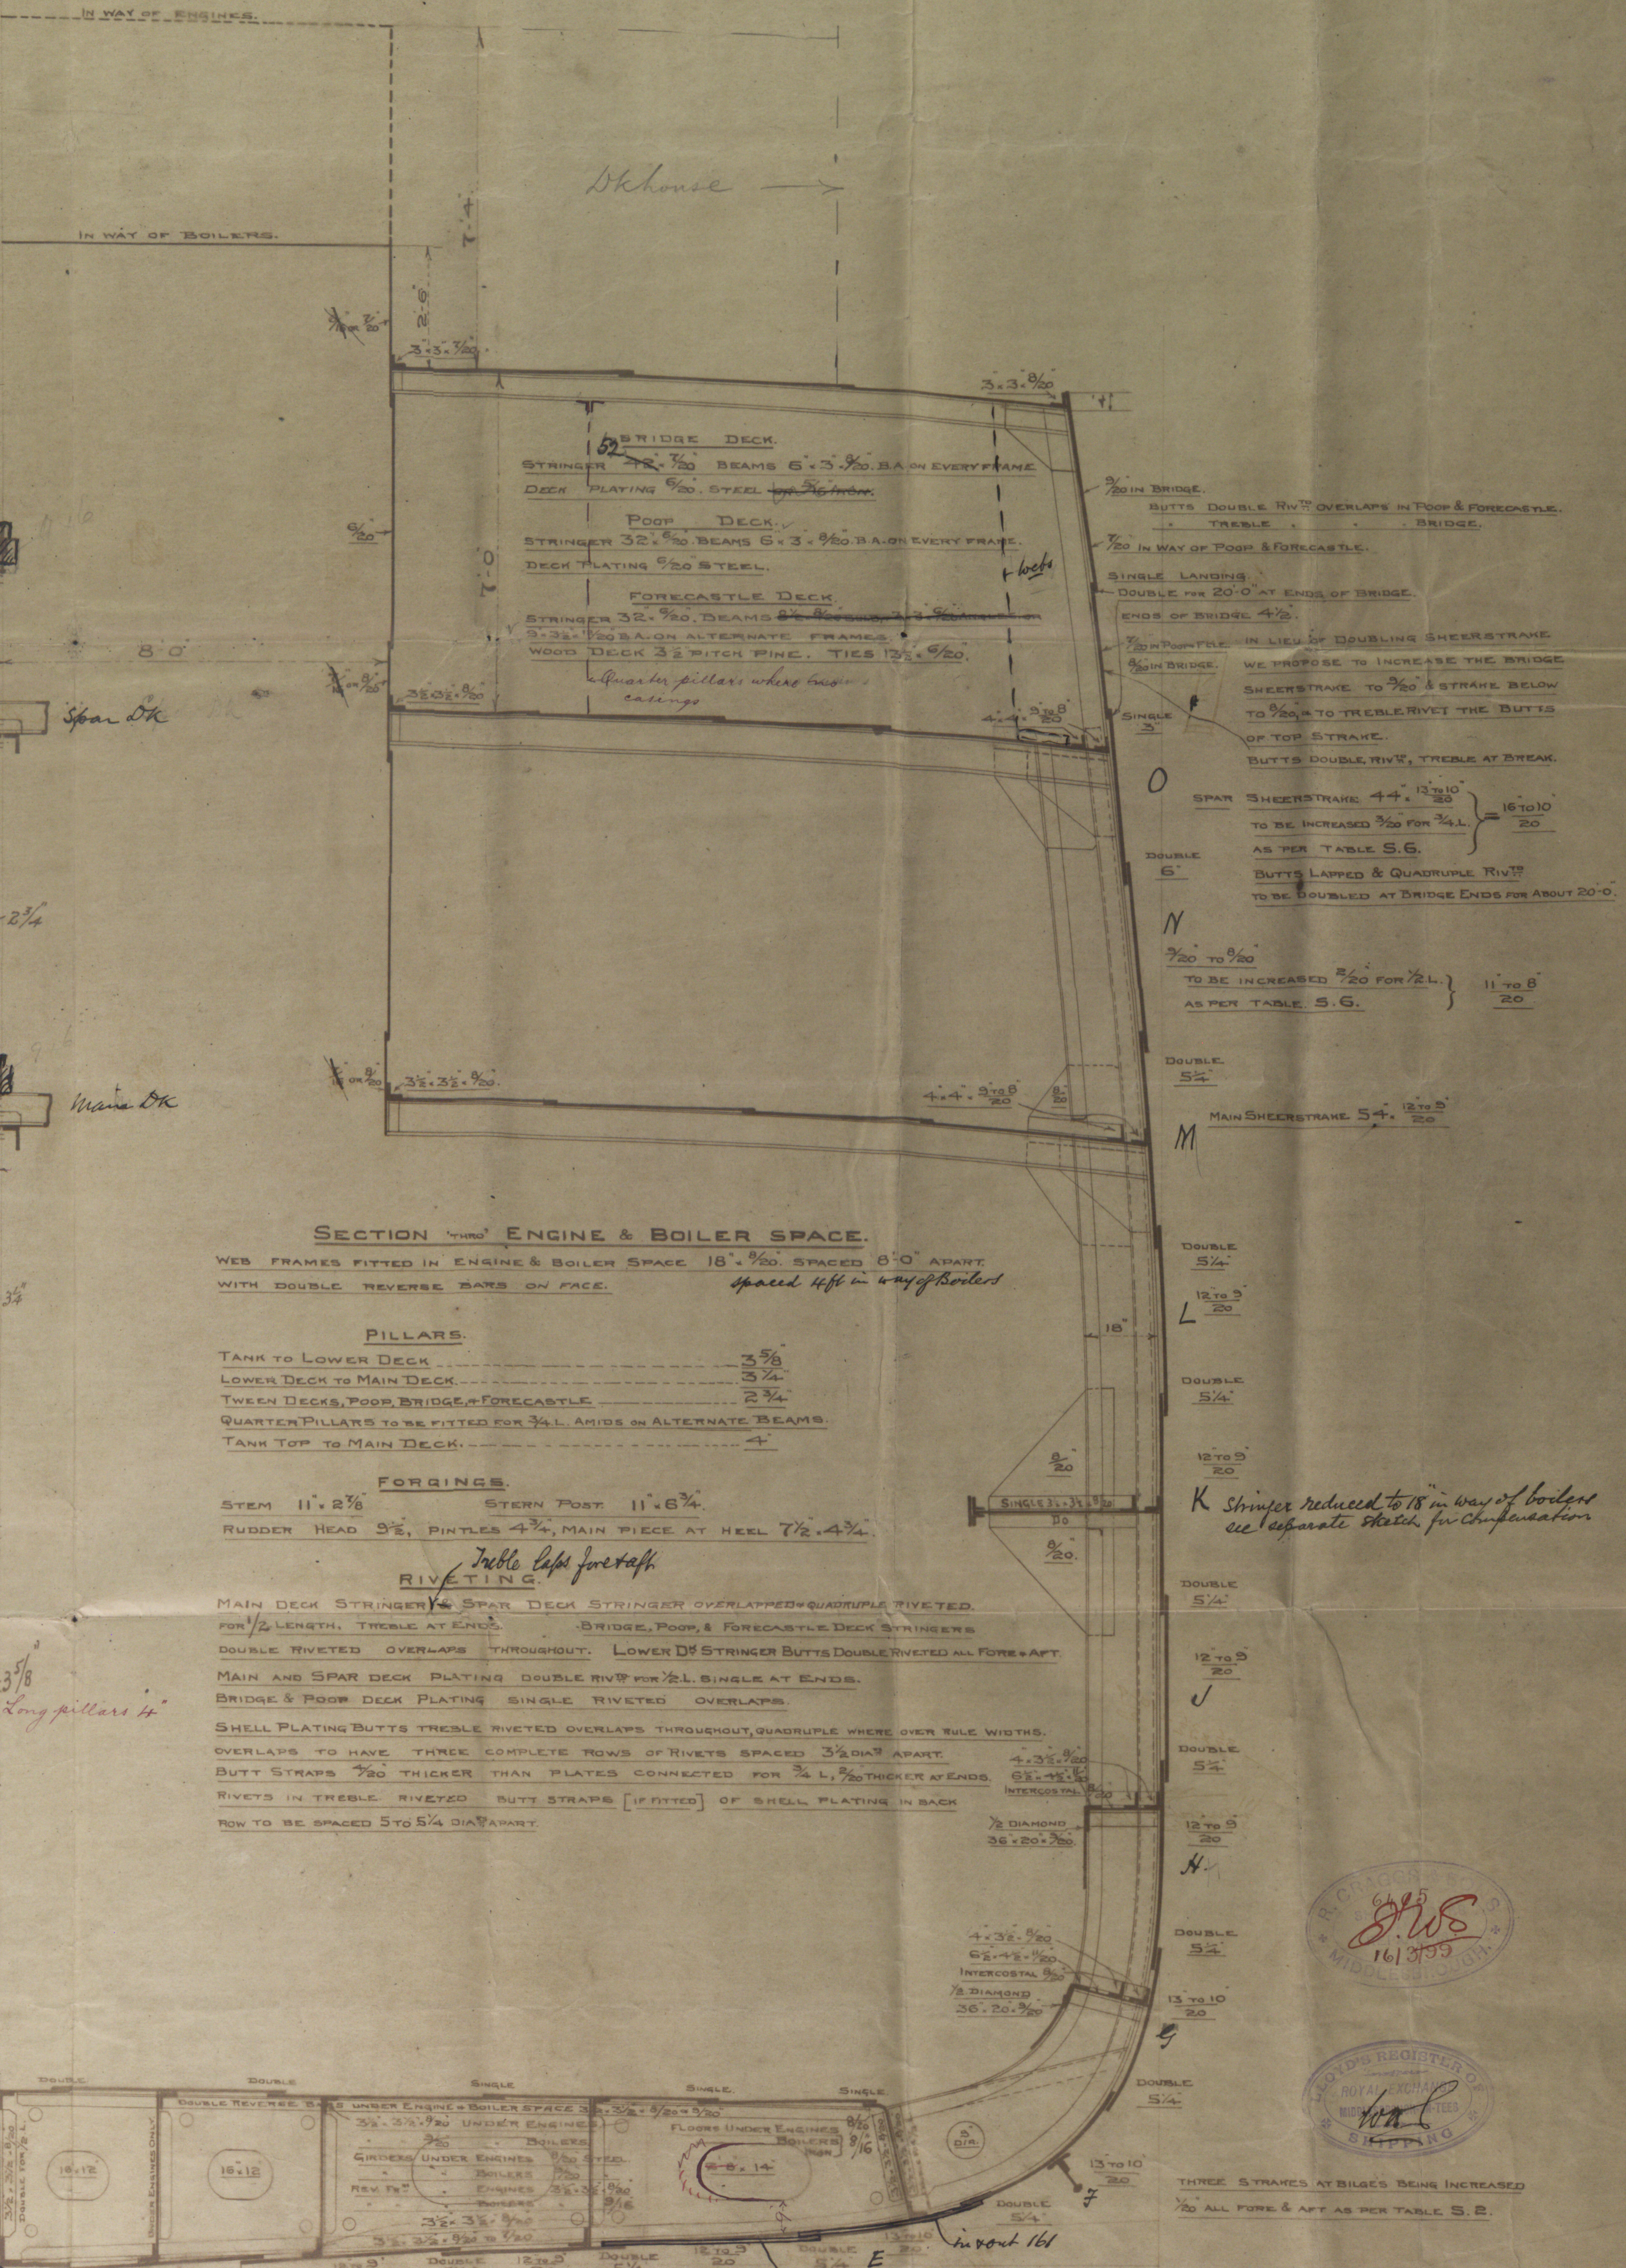

SECTION 'THRO' ENGINE & BOILER SPACE.

WEB FRAMES FITTED IN ENGINE & BOILER SPACE 18" \times $\frac{9}{16}$ " SPACED 8'-0" APART.
WITH DOUBLE REVERSE BARS ON FACE. *Spaced 4 ft in way of Boiler*

PILLARS

TANK TO LOWER DECK	3 5/8
LOWER DECK TO MAIN DECK	3 1/4
TWEEN DECKS, POOP, BRIDGE & FORECASTLE	2 3/4
QUARTER PILLARS TO BE FITTED FOR 3/4 L. AMIDS ON ALTERNATE BEAMS	
TANK TOP TO MAIN DECK.	4

FORGING

STEM $11 \times 2\frac{7}{8}$ STERN POST $11 \times 6\frac{3}{4}$
 RUDDER HEAD $9\frac{1}{2}$, PINTLES $4\frac{3}{4}$, MAIN PIECE AT HEEL $7\frac{1}{2} \times 4\frac{3}{4}$

note
BUTLER

MAIN DECK STRINGERS & SPAR DECK STRINGER OVERLAPPED & QUADRUPLE RIVETED.
FOR 1/2 LENGTH, TREBLE AT ENDS. BRIDGE, POOP, & FORECASTLE DECK STRINGERS
DOUBLE RIVETED OVERLAPS THROUGHOUT. LOWER DECK STRINGERS DOUBLE RIVETED ALL FORE & AFT.
MAIN AND SPAR DECK PLATING DOUBLE RIVETED FOR 1/2, SINGLE AT ENDS.
BRIDGE & POOP DECK PLATING SINGLE RIVETED OVERLAPS.
SHELL PLATING BUTTS TREBLE RIVETED OVERLAPS THROUGHOUT, QUADRUPLE WHERE OVER RILE WIDTHS.
OVERLAPS TO HAVE THREE COMPLETE ROWS OF RIVETS SPACED 3/2 DIA. APART. 1 1/2 IN.
BUTT STRAPS 7/8" THICKER THAN PLATES CONNECTED FOR 1/2, 1/2" THICKER AT ENDS. 6 1/2 IN.
RIVETS IN TREBLE RIVETED BUTT STRAPS [IF FITTED] OF SHELL PLATING IN BACK INTERSECT
ROW TO BE SPACED TO 5/4 DIA. APART. 7 1/2 DIA.

DOUBLE	SINGLE	SINGLE	SINGLE
REVERSE GEAR UNDER ENGINE - BOILER SPACE		$\frac{3}{8} \times \frac{3}{8} \times 20$	
$\frac{3}{8} \times \frac{3}{8} \times 20$	UNDER ENGINE	FLOOR UNDER ENGINE	$\frac{8}{16} \times \frac{1}{2}$
$\frac{3}{8}$	BOILERS	BOILERS	$\frac{9}{16} \times \frac{1}{2}$

[illegible]

DOUBLE 18.9' DOUBLE 12.9' DOUBLE 18.1' DOUBLE 18.1' E
20' B 5/4 C 5/4 D 5/4
15 12
20 20
in/out 161
REDUCED 1/20 UNDER TANK WHEN 11 1/2" THICK OR ABOVE

KEEL OUTSIDE 161
" INSIDE - 164


R. CRAGGS & SONS.

SHIPBUILDERS & REPAIRERS.

TEES DOCKYARD.

MIDDLESBROUGH-on-TEES.

48
24.3 79

NOTE:- IN LIEU OF FITTING DOUBLING TO KEEL PLATE AS REQUIRED BY RULE WE PROPOSE THE FOLLOWING VIZ; TO INCREASE PLAT PLATE KEEL $\frac{3}{16}$ " FOR $\frac{1}{2}$ " L. GANBOARDS $\frac{3}{16}$ " FOR $\frac{1}{2}$ " L, AND CENTRE GIRDER $\frac{1}{2}$ " FOR $\frac{1}{2}$ " L.

- Keel outside 161
" inside - 164

N^o 161 & 164

NIDB765-0170

© 2019

Lloyd's Register
Foundation

A. Craggs & Sons





No 161 & 164

Midship Section

25/3/99

No 161 & 164 Askehall

Yd Report No 2838

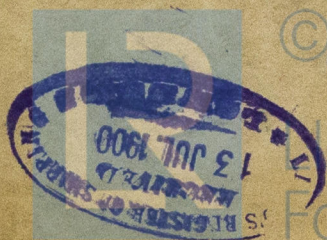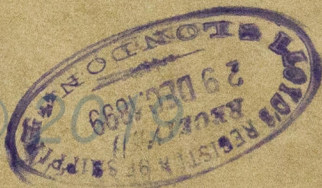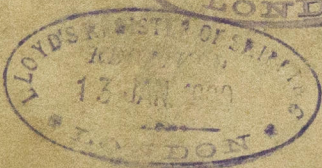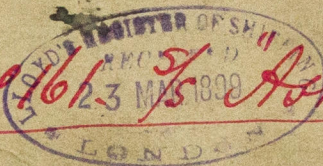

©

Lloyd's Register
Foundation

MDB765-0170