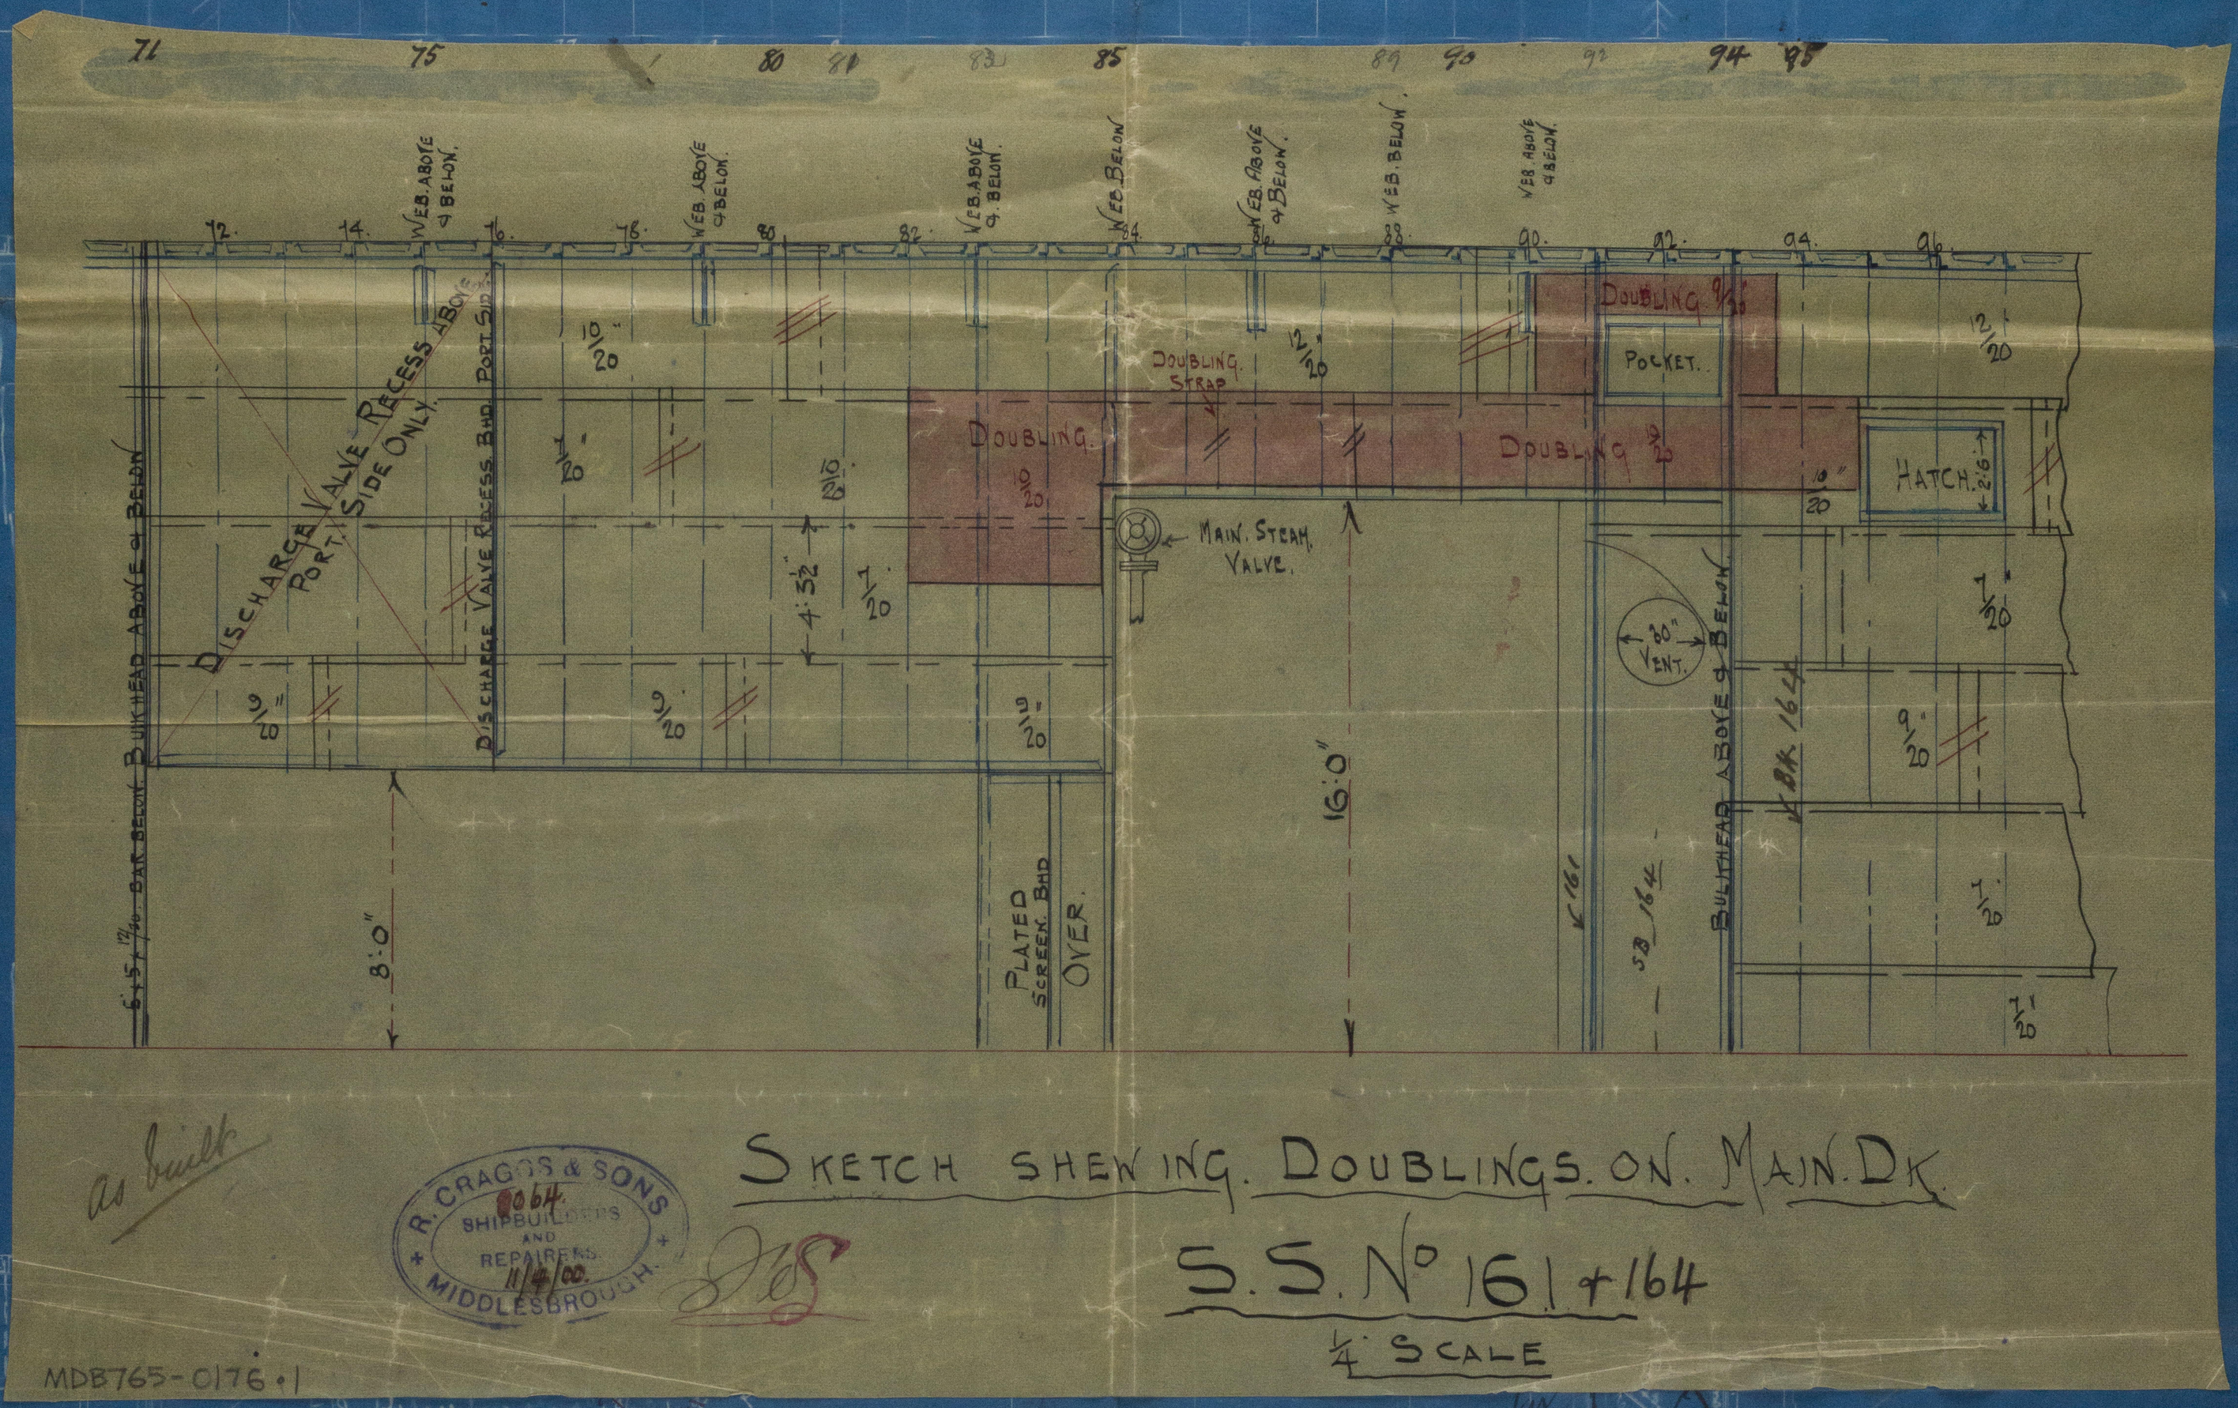

SKETCH SHEWING. DOUBLINGS. ON. MAIN. DK.

S.S. No 161 + 164

¼ SCALE

as built

R. CRAGGS & SONS
SHIPBUILDERS AND REPAIRERS
MIDDLESBROUGH.
0064
11/4/00.

MDB765-0176.1

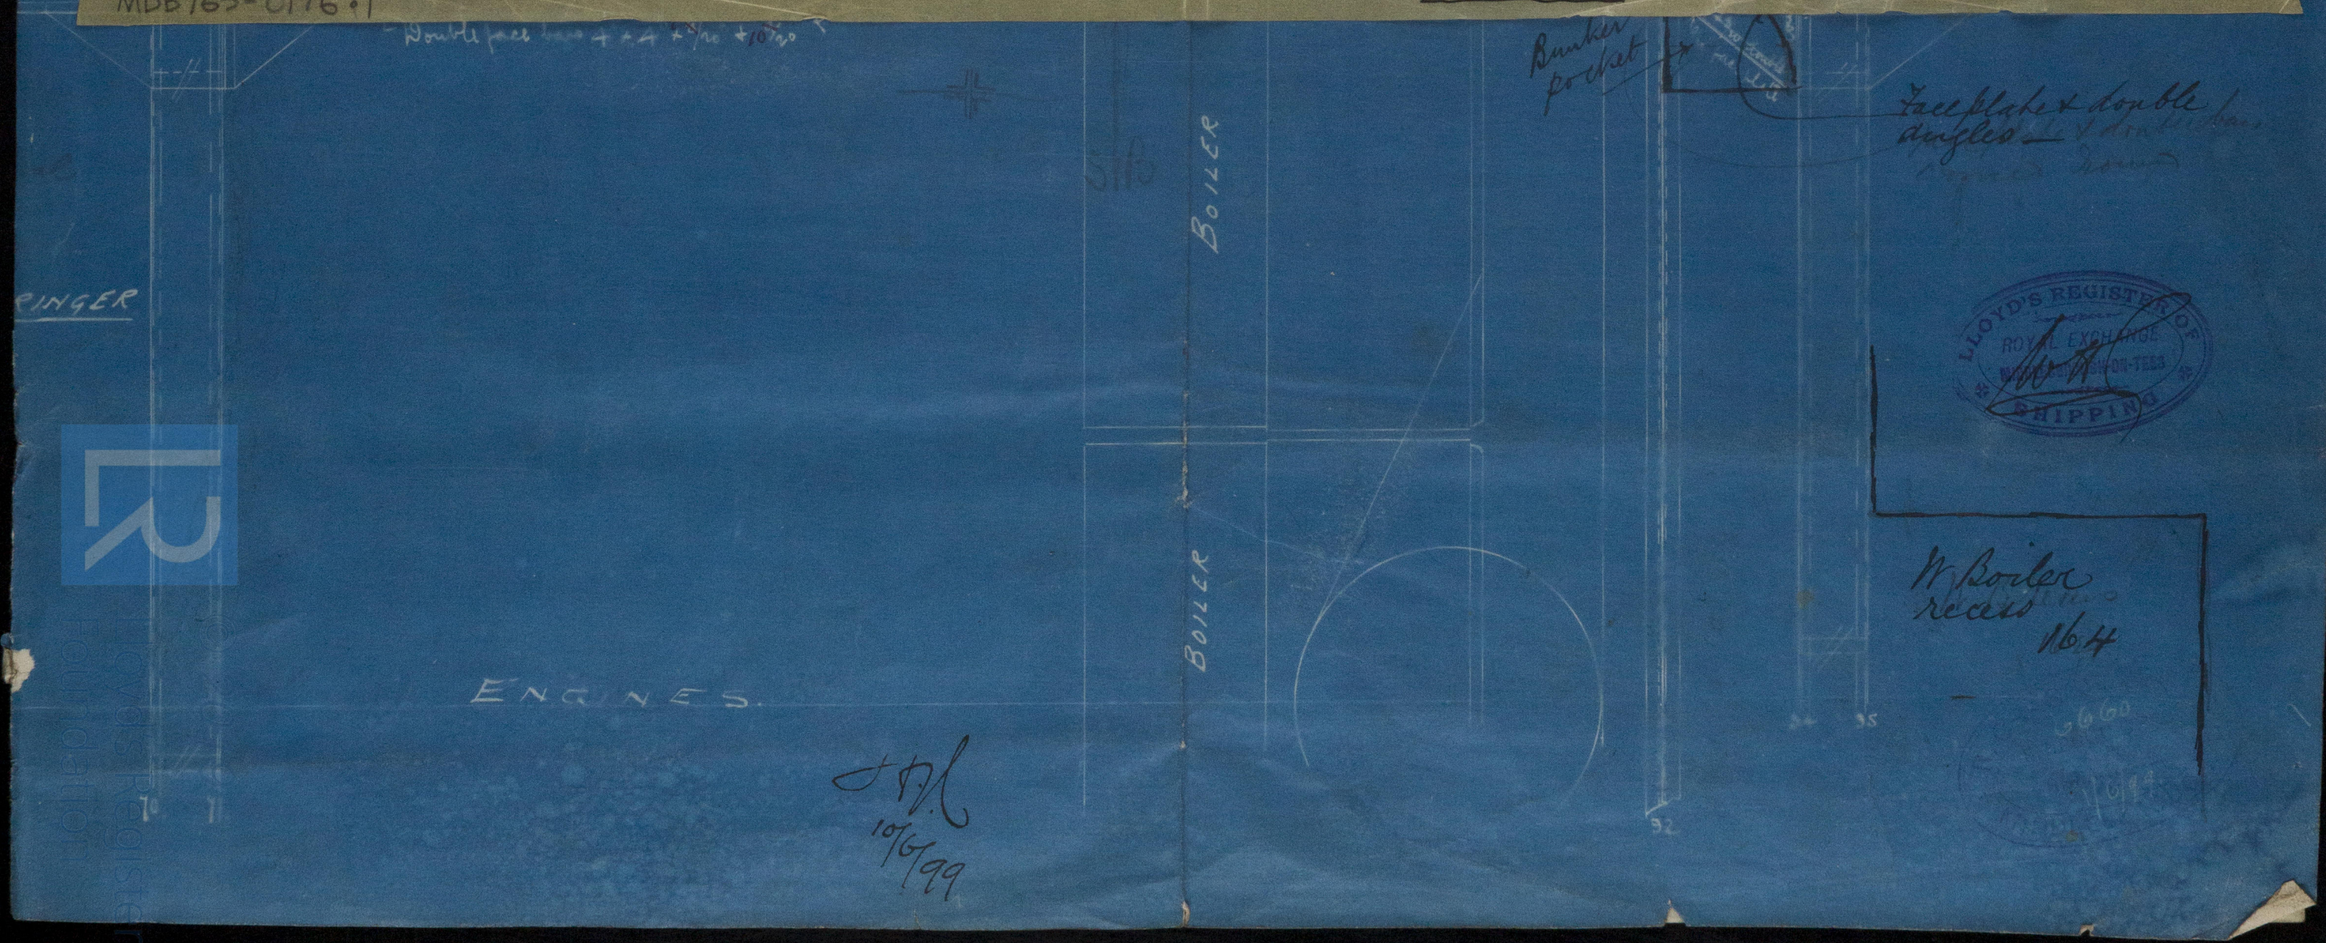

LLOYD'S REGISTER OF SHIPPING
ROYAL EXCHANGE
MIDDLESBROUGH-ON-TEES

10/6/99