

— STEEL LOWERMASTS. —

— SCALE $\frac{1}{4}$ INCH = 1 FOOT. —


MASTS TO BE MADE IN TWO PLATES IN THE ROUND, FORE STRAKE OUTSIDE.
BUTTSTRAPS FITTED INSIDE.

ALL BUTTSTRAPS TREBLE RIVETED AND $\frac{2}{32}$ THICKER THAN PLATES.

BUTTS AND SEAMS RIV^d WITH $\frac{3}{4}$ RIVETS, 5 DIAS. APART. SEAMS SINGLE RIVETED.

MASTS TO CARRY FORE AND AFT SAILS ONLY.

— FORE AND MAIN MASTS. —

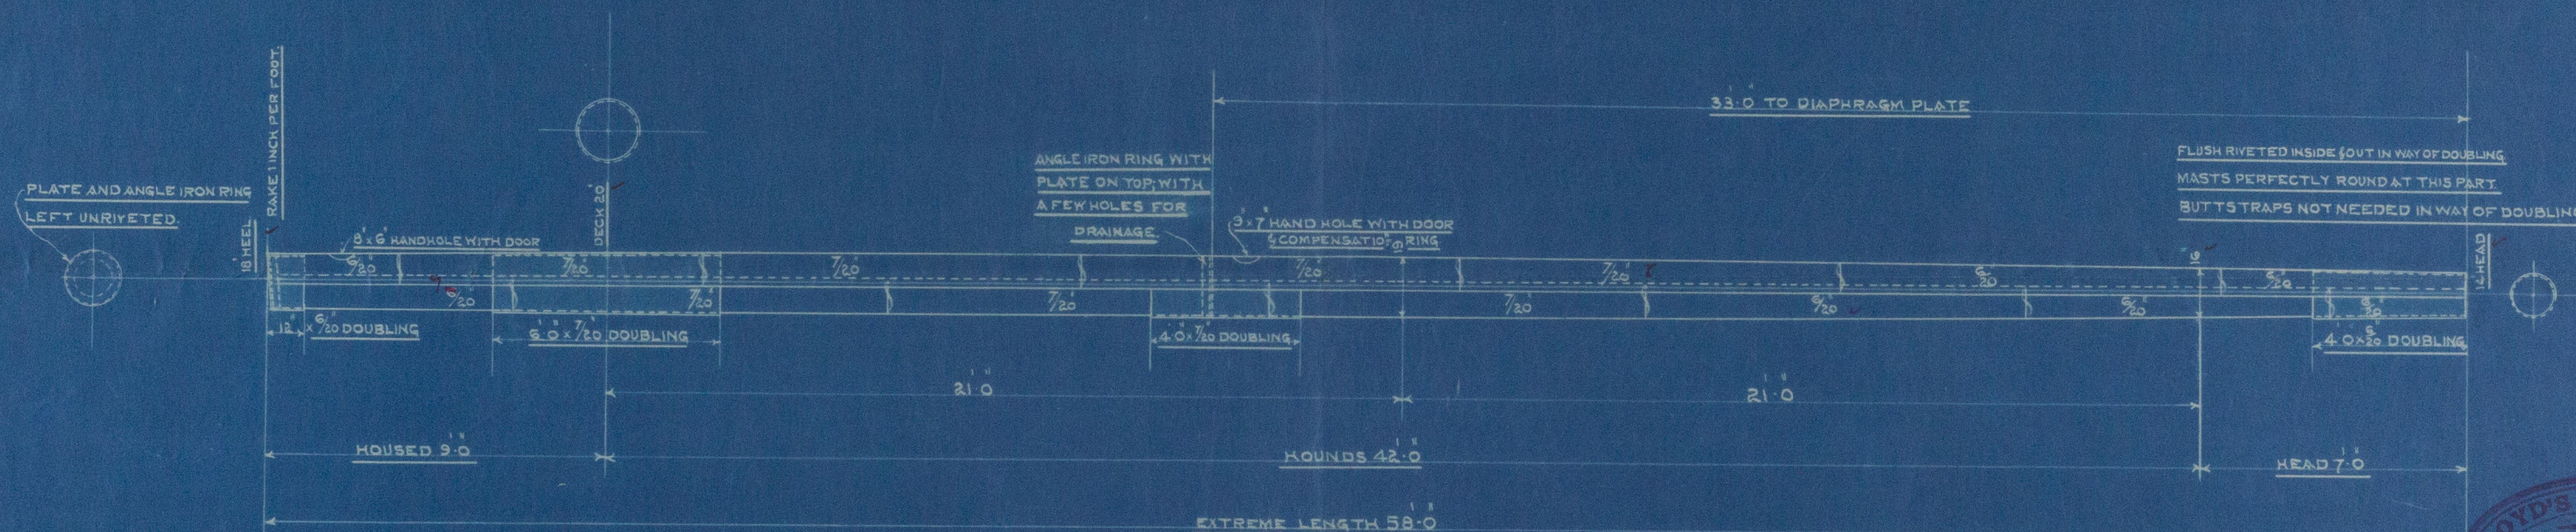

N^o 373. and 376.



Lloyd's Register Foundation

MAD 3 766-0163

Tract Plan.

Popner & Sons

No 343 + 371

^{Dobles}
S.S. 'Acis' (373)

Libro Report. No 2925.

S.S. 'Penare' (376)

Libro Report. No 3003



© 2021

Lloyd's Register
Foundation

MD8766-0163