

For the information of Surveyors and the Committee only,

s/s 'Acis'

Received at Middlesbrough Office. 6th July 1900

Lloyd's Register of British and Foreign Shipping.

Middlesbrough (Report on Vessel No. 2925 Port Mab.)No. 4176a. SHIP FORGINGS OR CASTINGS.I have to report that the undermentioned Iron or ~~Steel~~ Forgings or Castings,
manufactured by Imp^r Wad Wighton & Co.of Stockton for the Vessel No. 373, being built
by Imp^r Roper & Son of Stocktonhave been inspected by me as set forth below, and found to be, so far as can be seen,
sound.



Mark on Forgings.

Lloyd's

No. 4176a
W.C.Wm CameronSundaland
5/7/00

	STERN FRAME.	RUDDER FRAME.	STEM.
Material*	<u>Scrap</u>	<u>Scrap</u>	<u>Scrap</u>
How made	<u>Forged</u>	<u>Forged</u>	<u>Forged</u>
Dimensions	<u>11" x 6"</u>	<u>8 1/2" - 4 1/4"</u>	<u>11" x 2 5/8"</u>
Progress on Inspection	<u>Forged & Smithed</u>	<u>Forged & Smithed</u>	<u>Forged</u>
Date when Inspected	<u>July 1st to April 12/1900</u>	<u>May 22nd to June 26/1900</u>	<u>June 30/1900</u>

SKETCHES OF FRAMES SHOWING POSITION AND DESCRIPTION OF WELDS OF FORGINGS, OR PARTICULARS OF TESTS APPLIED TO CASTINGS.

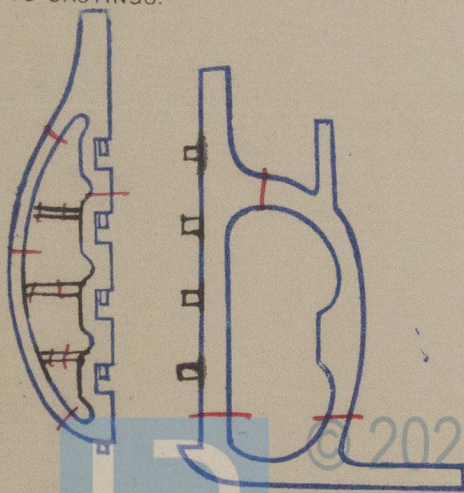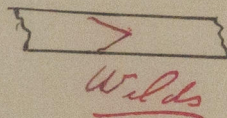

Fee (if any chargeable) £

To be paid at