

Speke Mill 1800

Lloyd's Register of British and Foreign Shipping.

(Printed in the London Office.)

P.

No. 18

REPORT ON SHIP FORGINGS.

Sir,

I beg leave to report that the undermentioned Forgings, manufactured by the Beek Ship & Dry Dock Co of Cardiff for the Vessel No 260, being built by Messrs J. R. Oswald & Co of Milford Haven have been inspected by me in course of being forged and smithed, and found to be, so far as can be seen, sound, good and efficient

Mark on Forging.

Lloyd's No. 10

I am, Sir,


Your Obedient Servant,

J. G. Rule

The Surveyor Milford Haven

Table with 4 columns: Material, How made, Dimensions, Progress on Inspection, Dates when Inspected. Rows for STERN FRAMES, RUBBER FRAMES (Keel Bars), and STEMS.

SKETCHES OF FRAMES SHEWING POSITION AND DESCRIPTION OF WELDS.

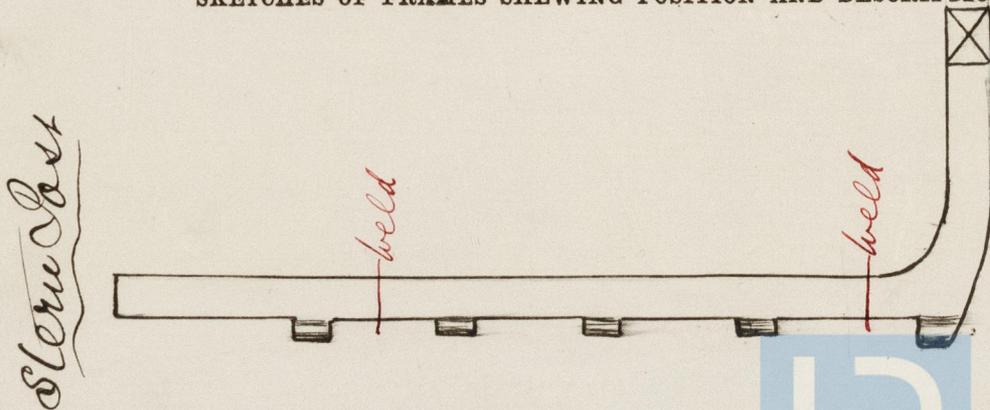

Stern Bar



© 2021 Lloyd's Register Foundation

* If of iron, state whether scrap or puddled iron.