



24.1.91.

Wunderman

PANTING ARRANGEMENT,

Nº 261 SHIP.

Scale $\frac{1}{8}$ = One Foot,

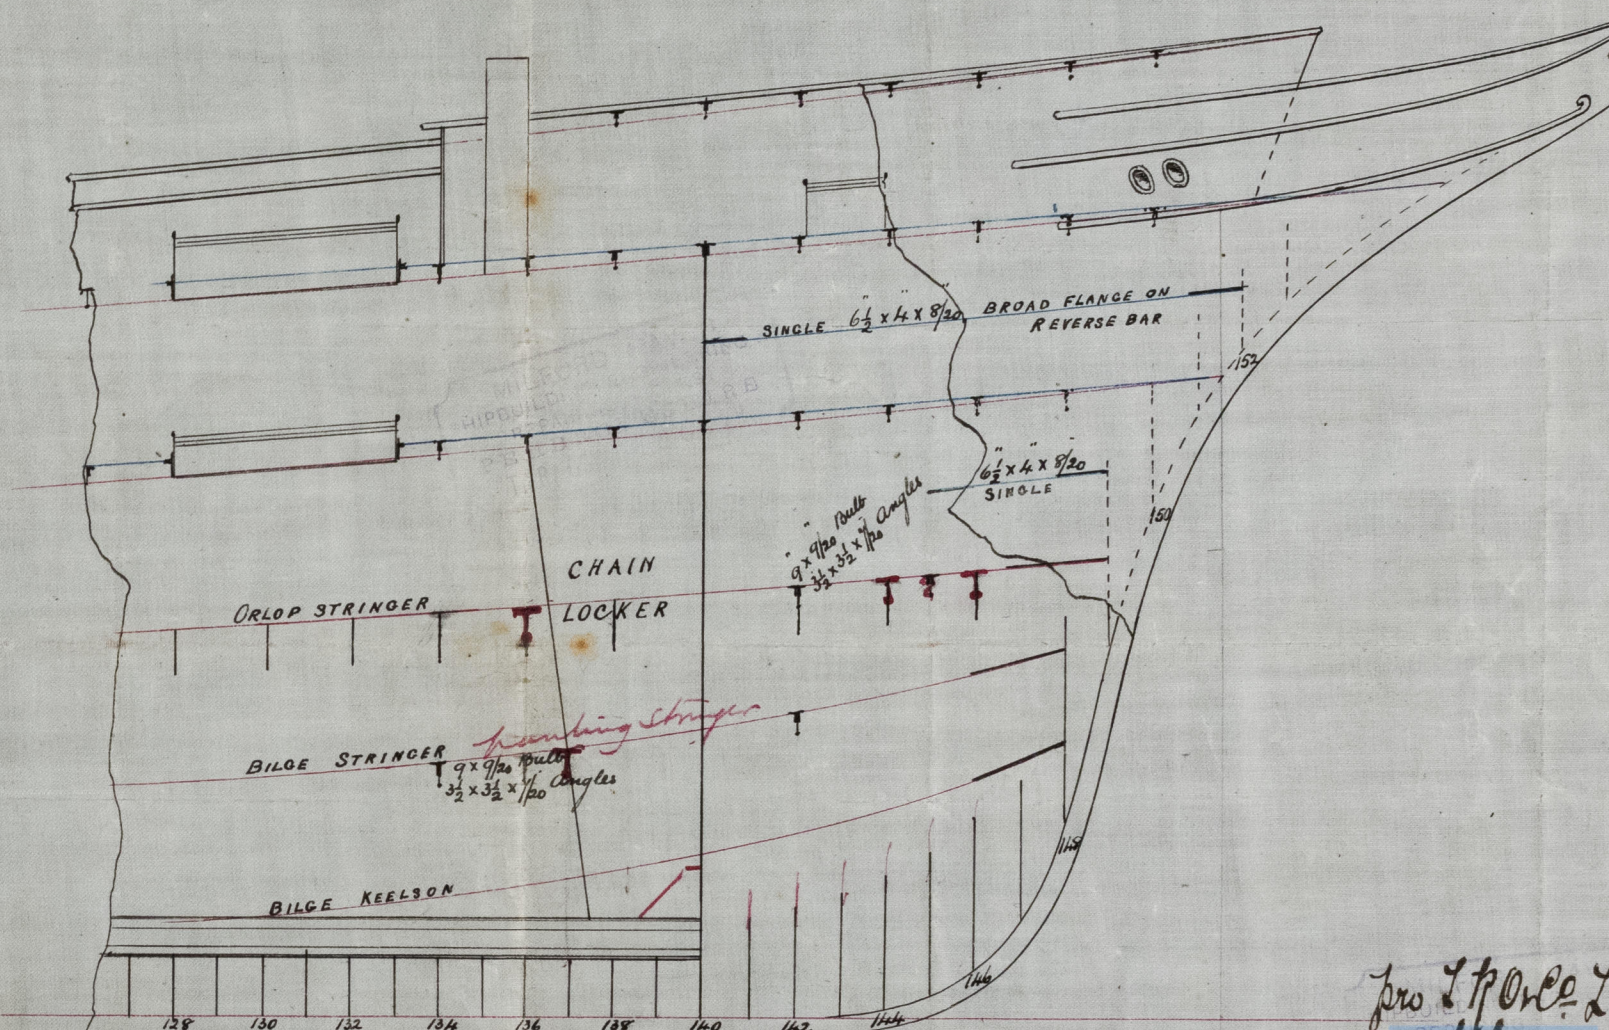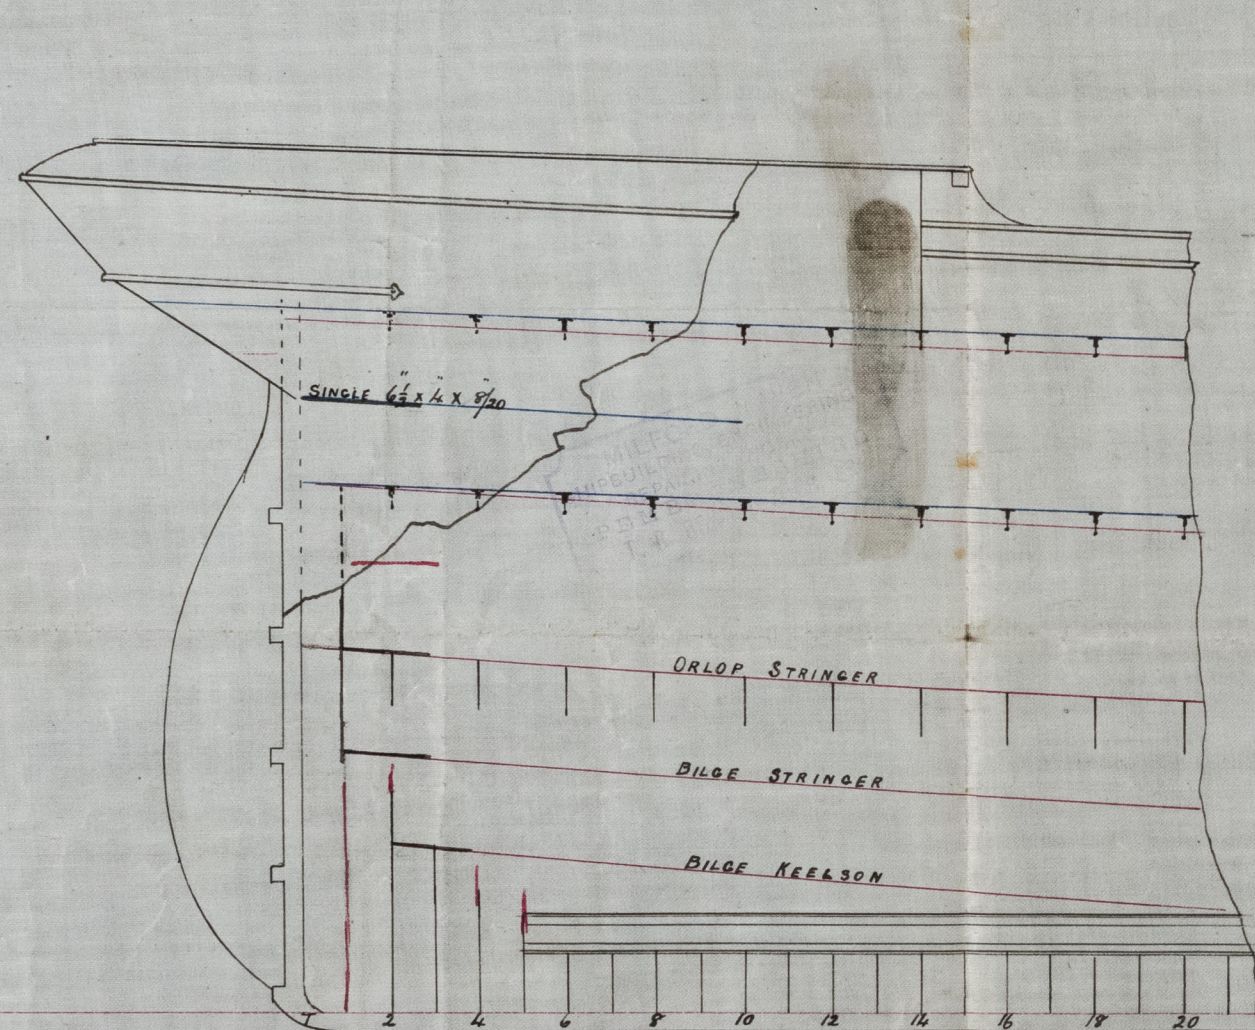

J.H.
23/1/91

pro I.P.O. Ltd.
P.B. 20/1/91

Steele B. K. Windermerere
Milford Haven
