




Ans to Msl.

570186 Report No. 284

Port of Marseilles
the 2^d of October 1886

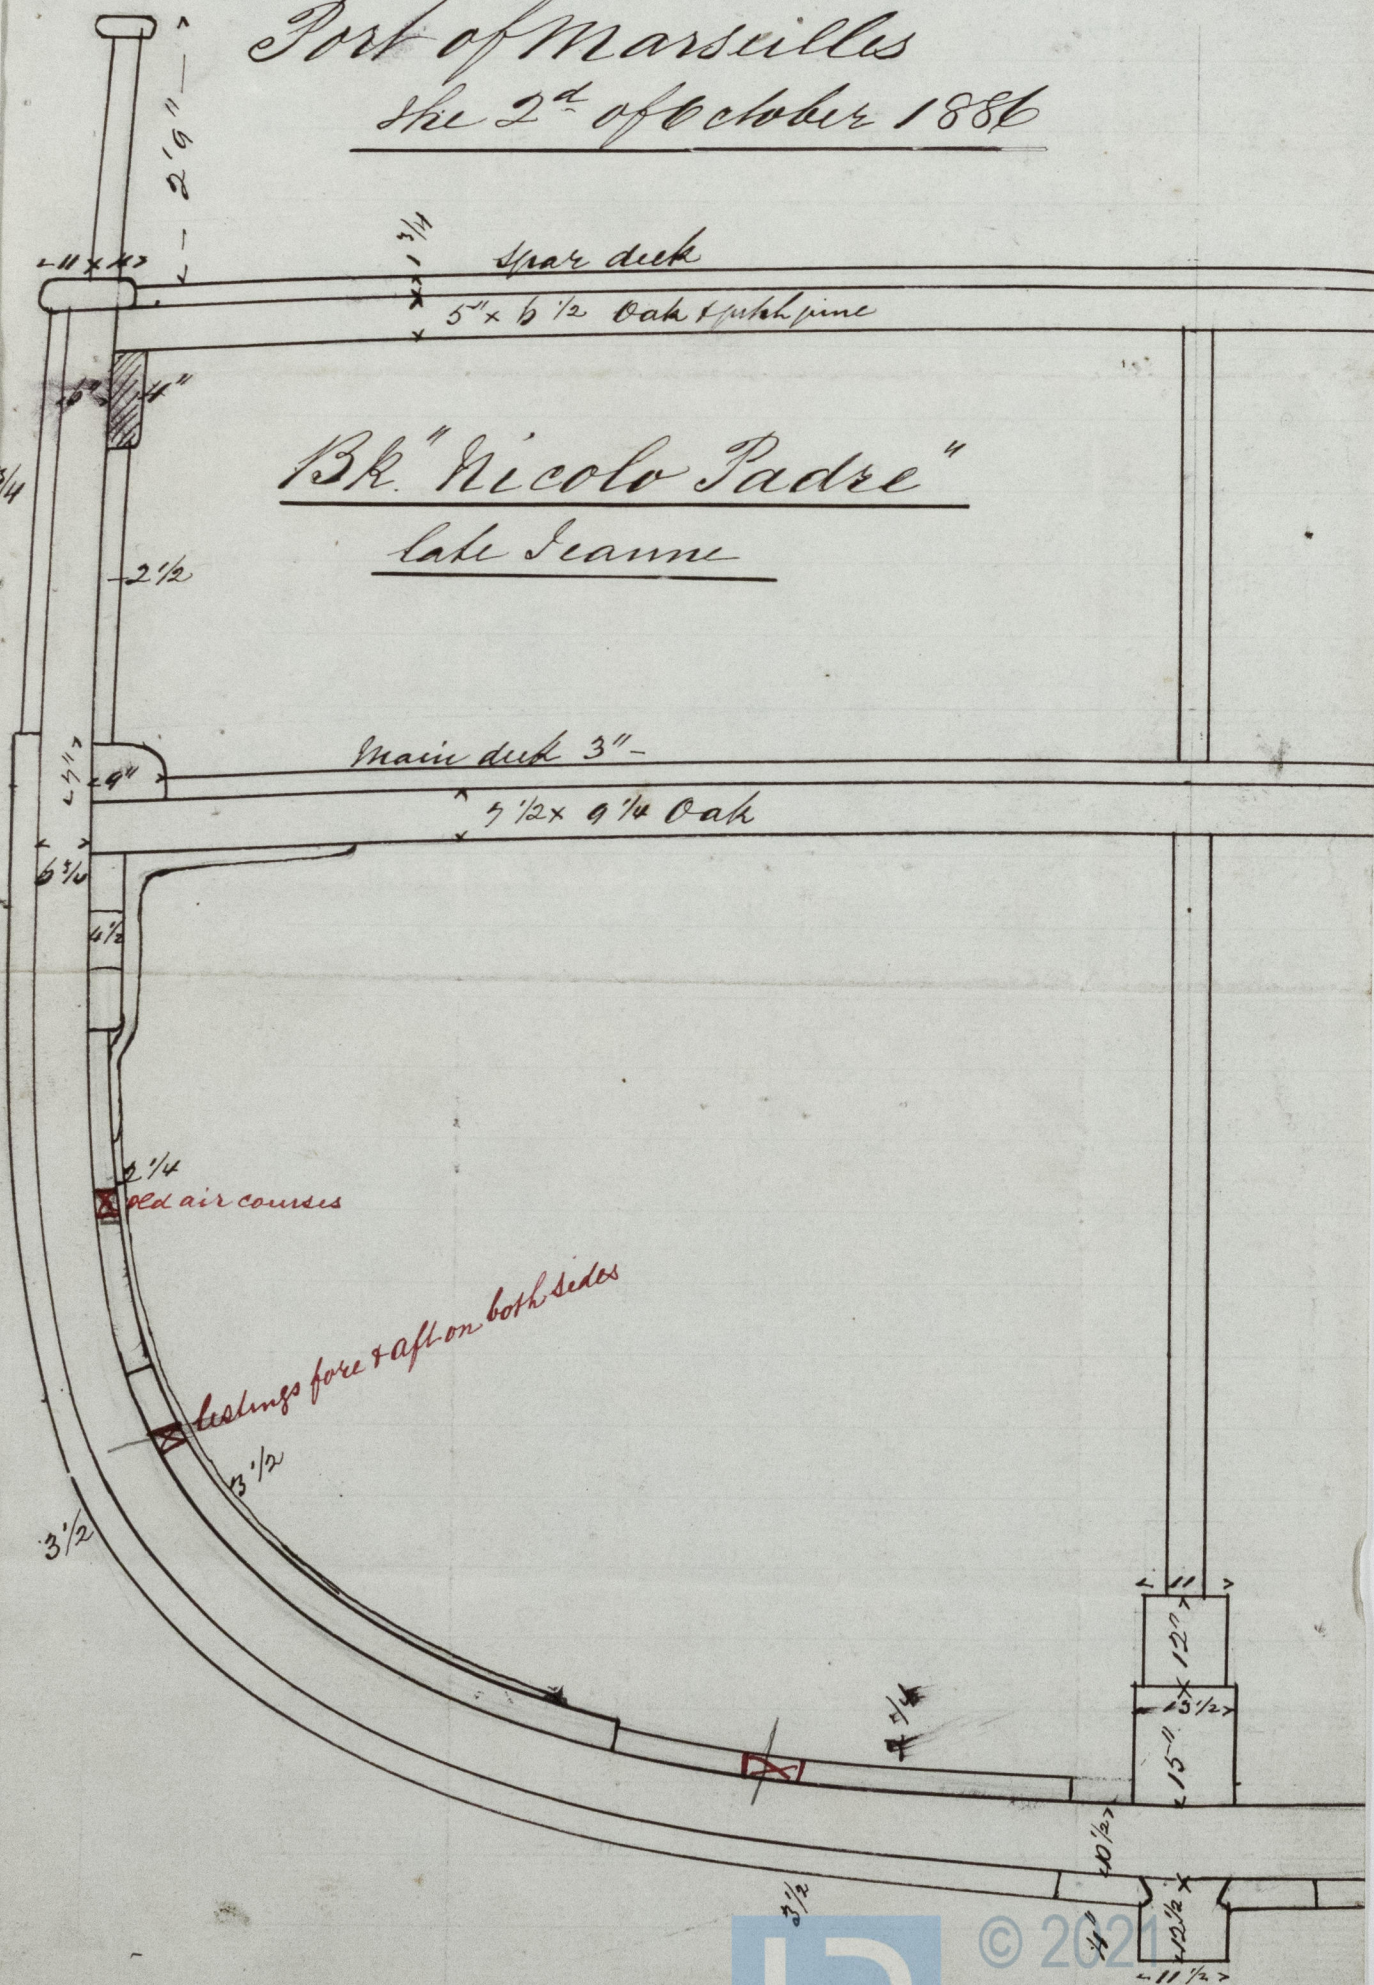

© 2021

Lloyd's Register
Foundation