


S. S. Zamboni
 Shot showing test holes drilled.

Black L.C. Side

Red Post. Side
 Shows 1st & 2nd Report
 Report Date March 1911. Drawing Date

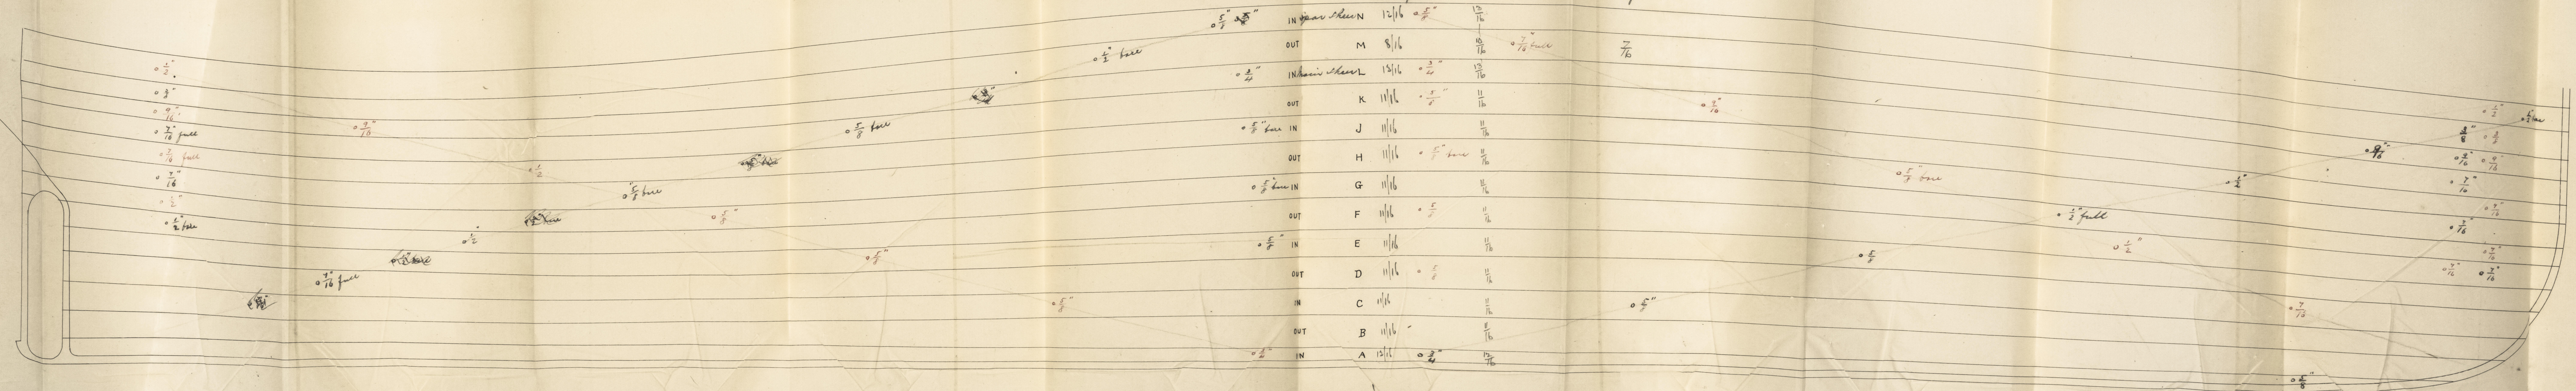

Original thickness in pencil