

MIDSHIP SECTION OF S.S.

227 Lengthened
Twenty feet. 188.
See other news.

Nº 227-28

Novo. Zambesi Glasgow report
No. 3643

SCALE $\frac{1}{2}$ INCH TO A FOOT

Depth 29.41
Half Breadth 18.25

Half Breadth 18.25

Girth 42.33

$$\begin{array}{r} 89.99 \\ 7 \\ \hline 82.99 = \text{Numeral} \end{array}$$

Length $328.16 \times 82.99 = 27.233$

Proportions Depth to Upper 11.15

'do "Main 14.99

Beams 8.9

Equipment Number 29,531

3 Bower Anchors 2 @ 34 Cwts ea Stock Admiralty test 31 $\frac{13}{20}$

Feb 1 " 29

1 Stream 13 1/2 Cwt with stock.

2 Wedges each $6\frac{3}{4}$ & $3\frac{1}{4}$ lbs.


300 lbs 1¹⁴/₁₆ Stud Chain Cable proved to Admiralty test of 6 ⁵/₂₀ tons.

90 fms 1²/₁₆ Chain or 11" Rope for Stream

90 " 11" Hawser

90 "

4 1/2 " Warpi

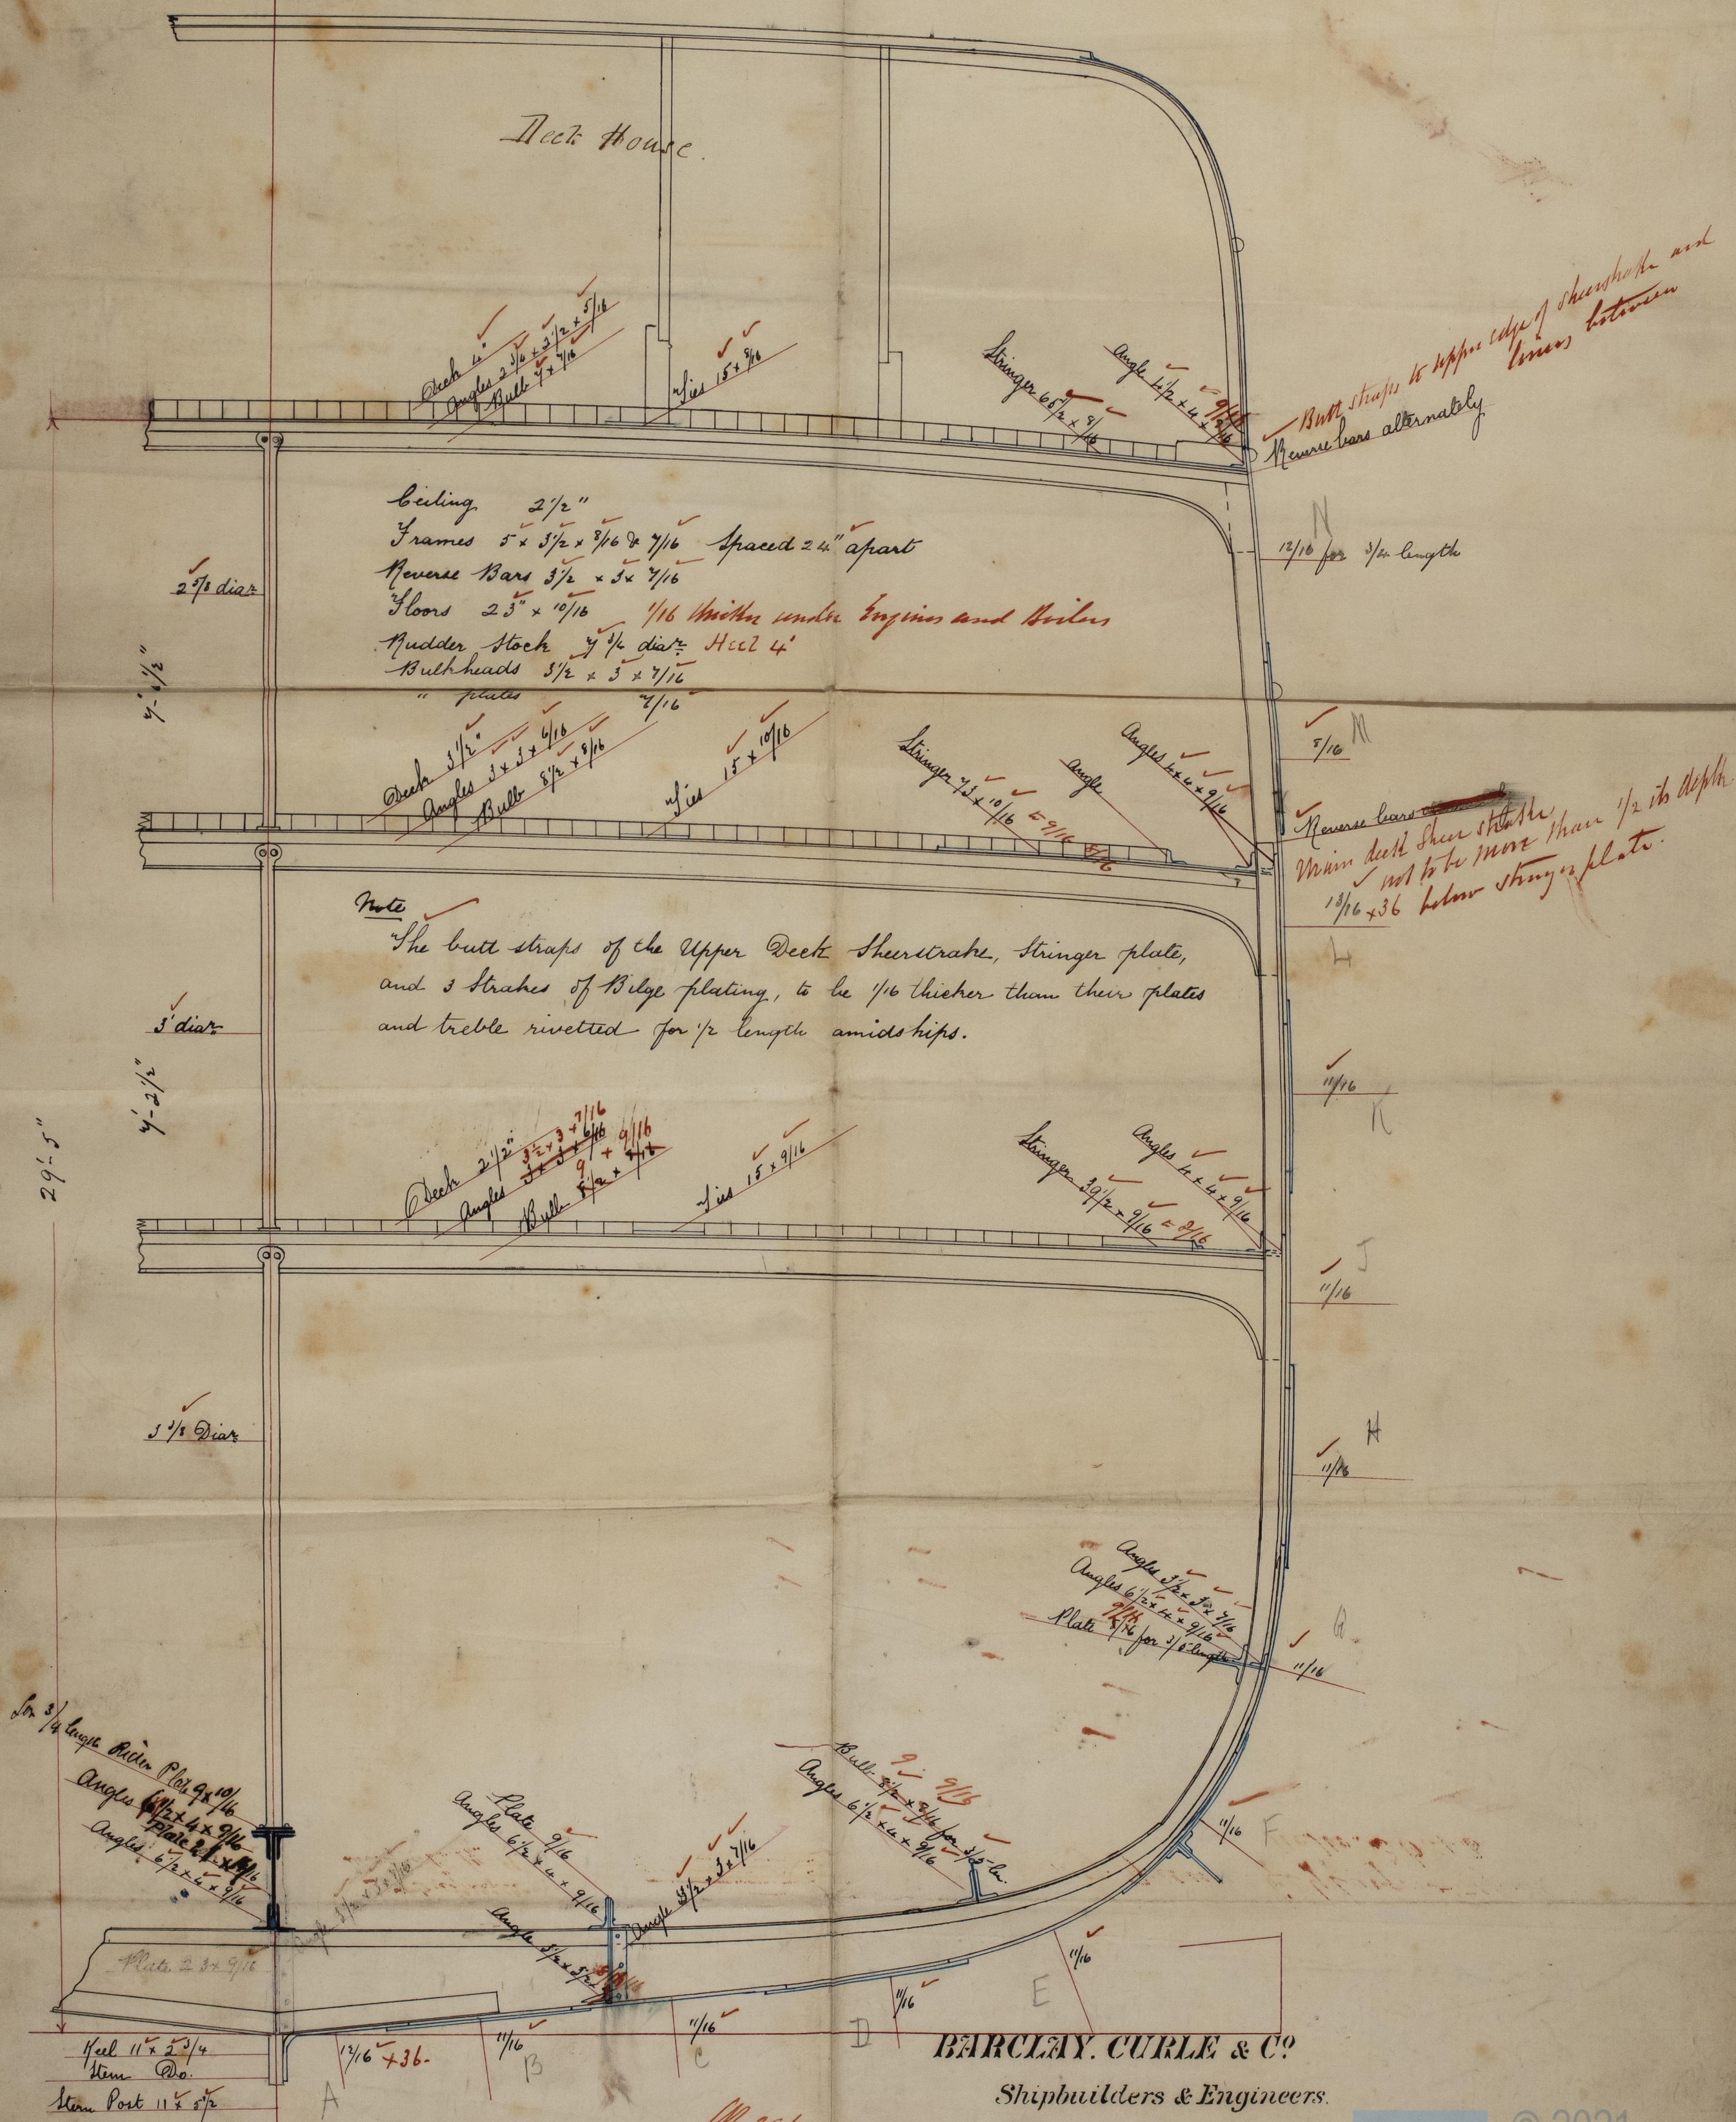

BARCLAY, CURLE & CO

Shipbuilders & Engineers.

GLASGOW.

29/9/41