
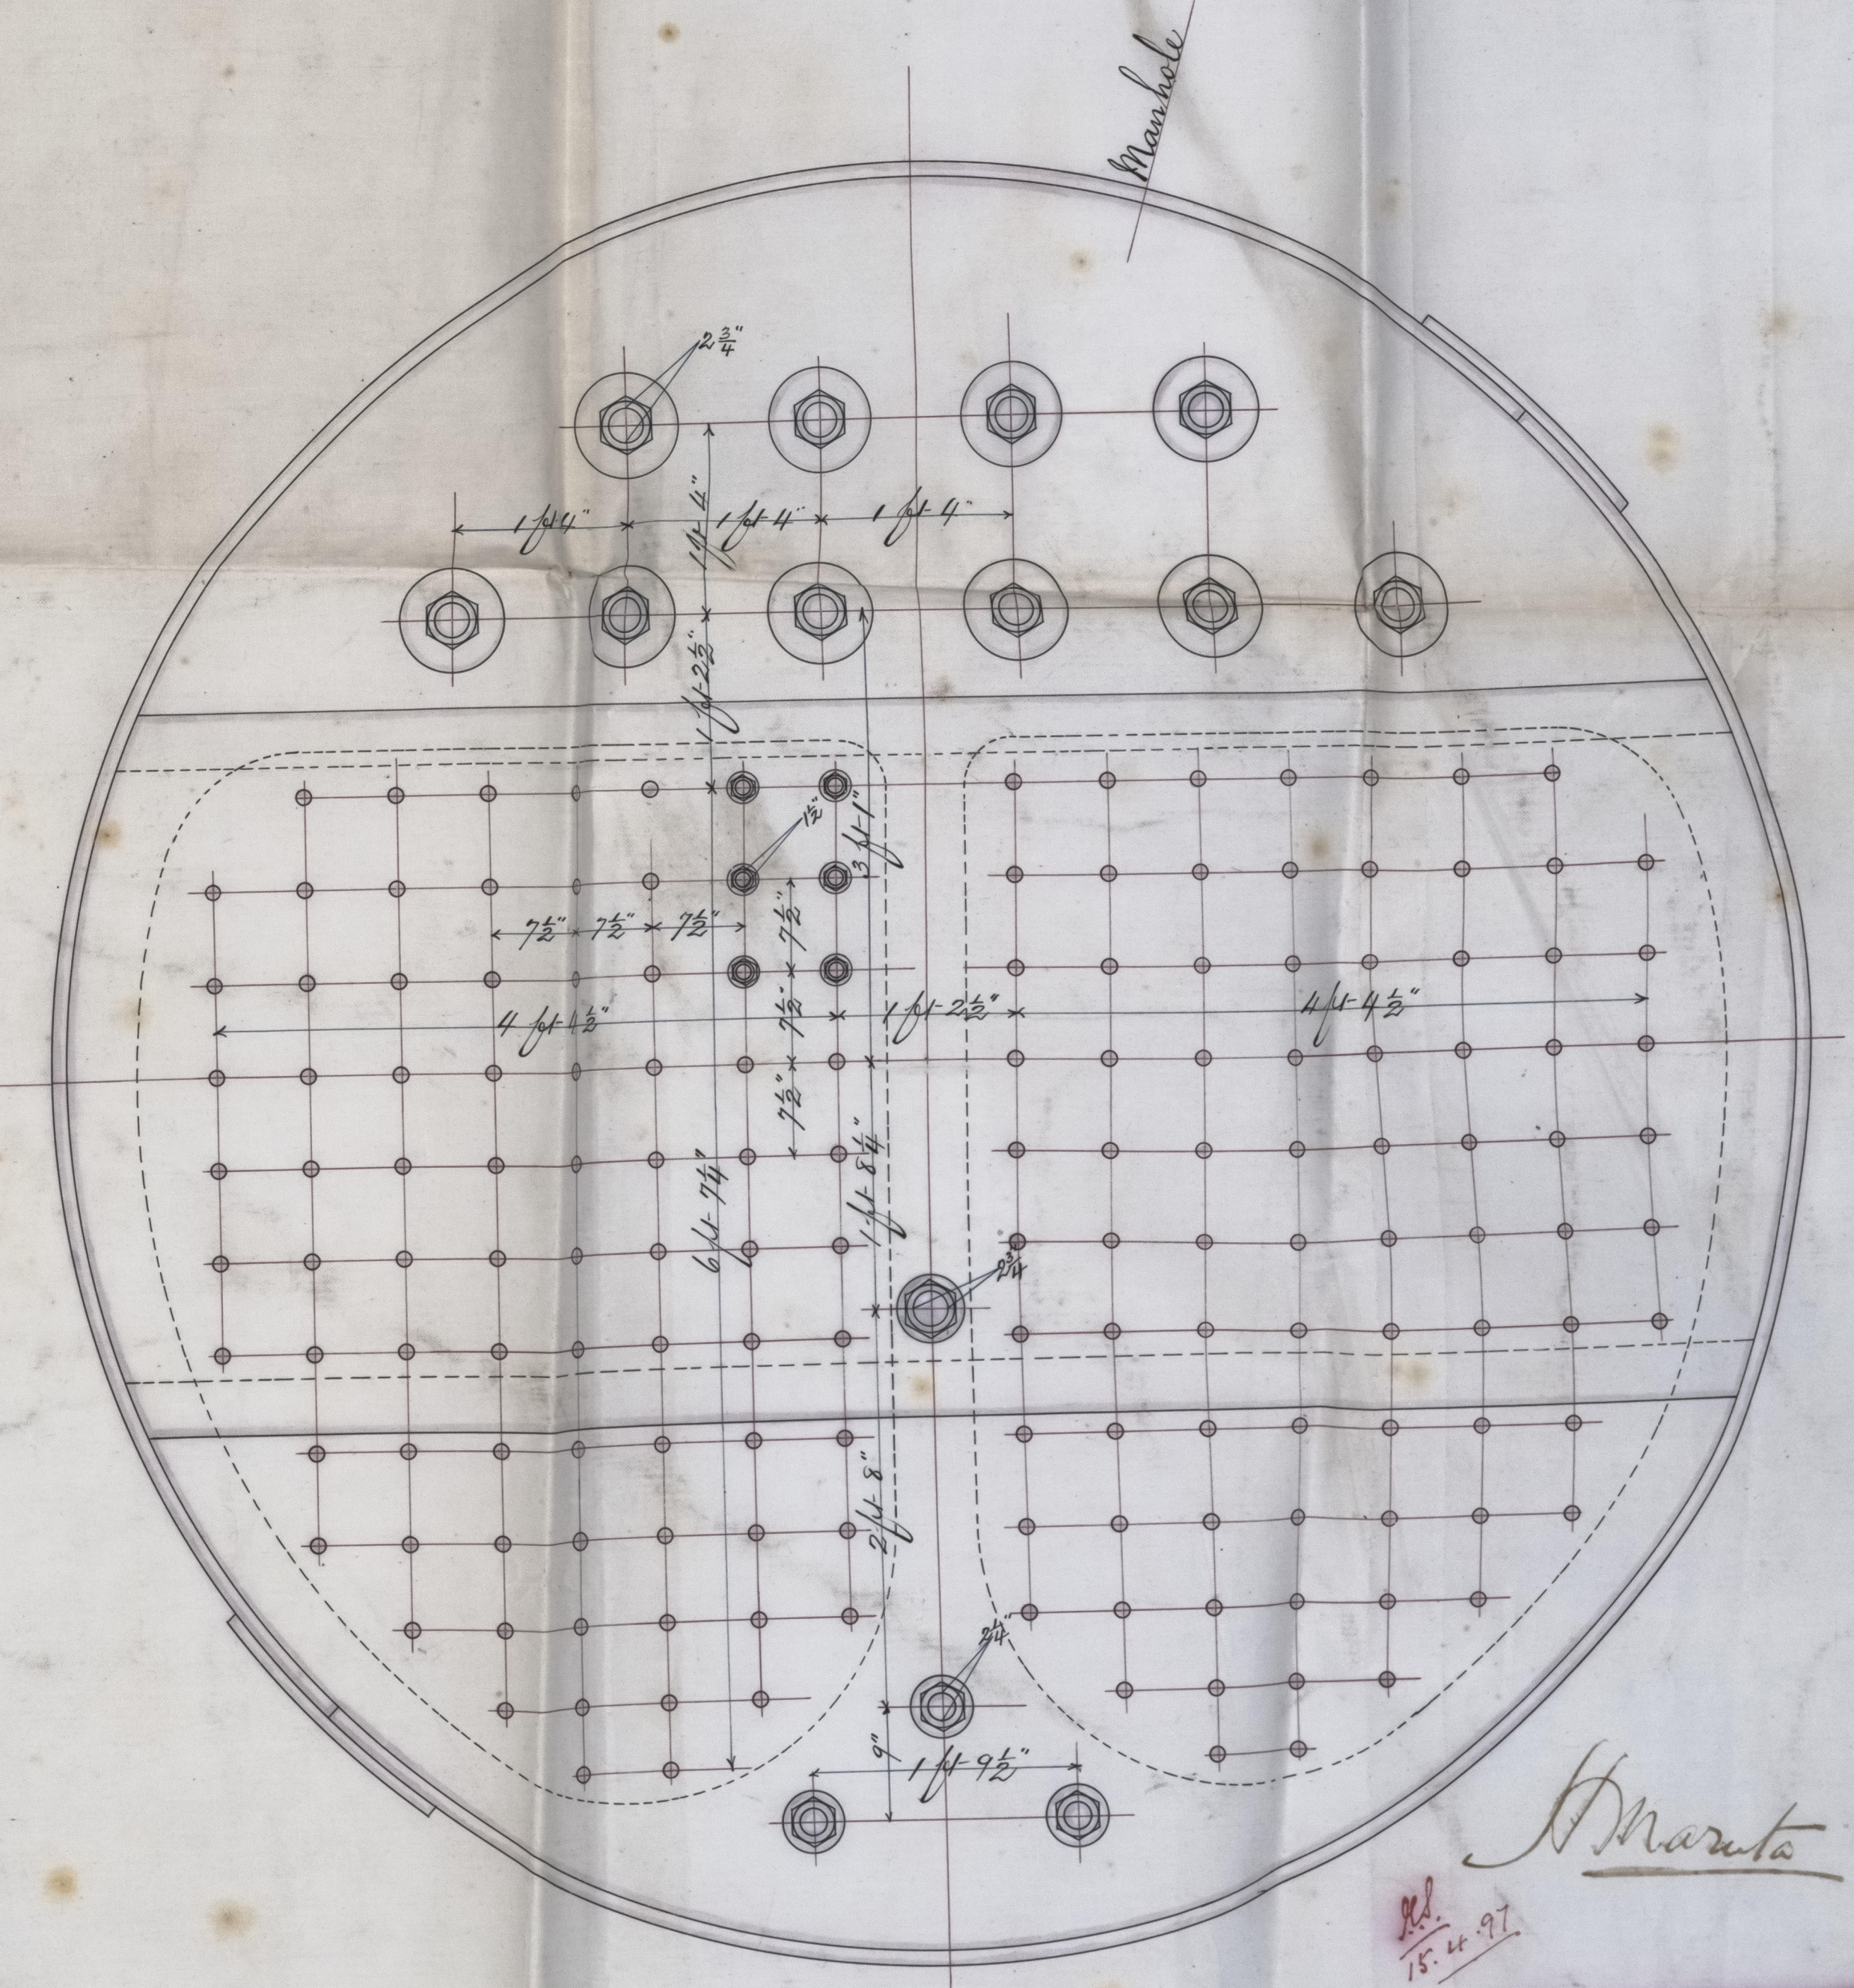


SCALE 1" TO THE FOOT.

Dimensions	
Mean Diameter of Boiler	12 ft 0"
Length " "	11 ft 1"
Heating Surface in Tubes	12161.59 sq. ft.
" " " Furnace	87.133 " "
" " " Fire Box	88.573 " "
" " " Back tube plate	26.680 " "
Total Heating Surface	1429.245 " "
" Grate " "	37.127 " "

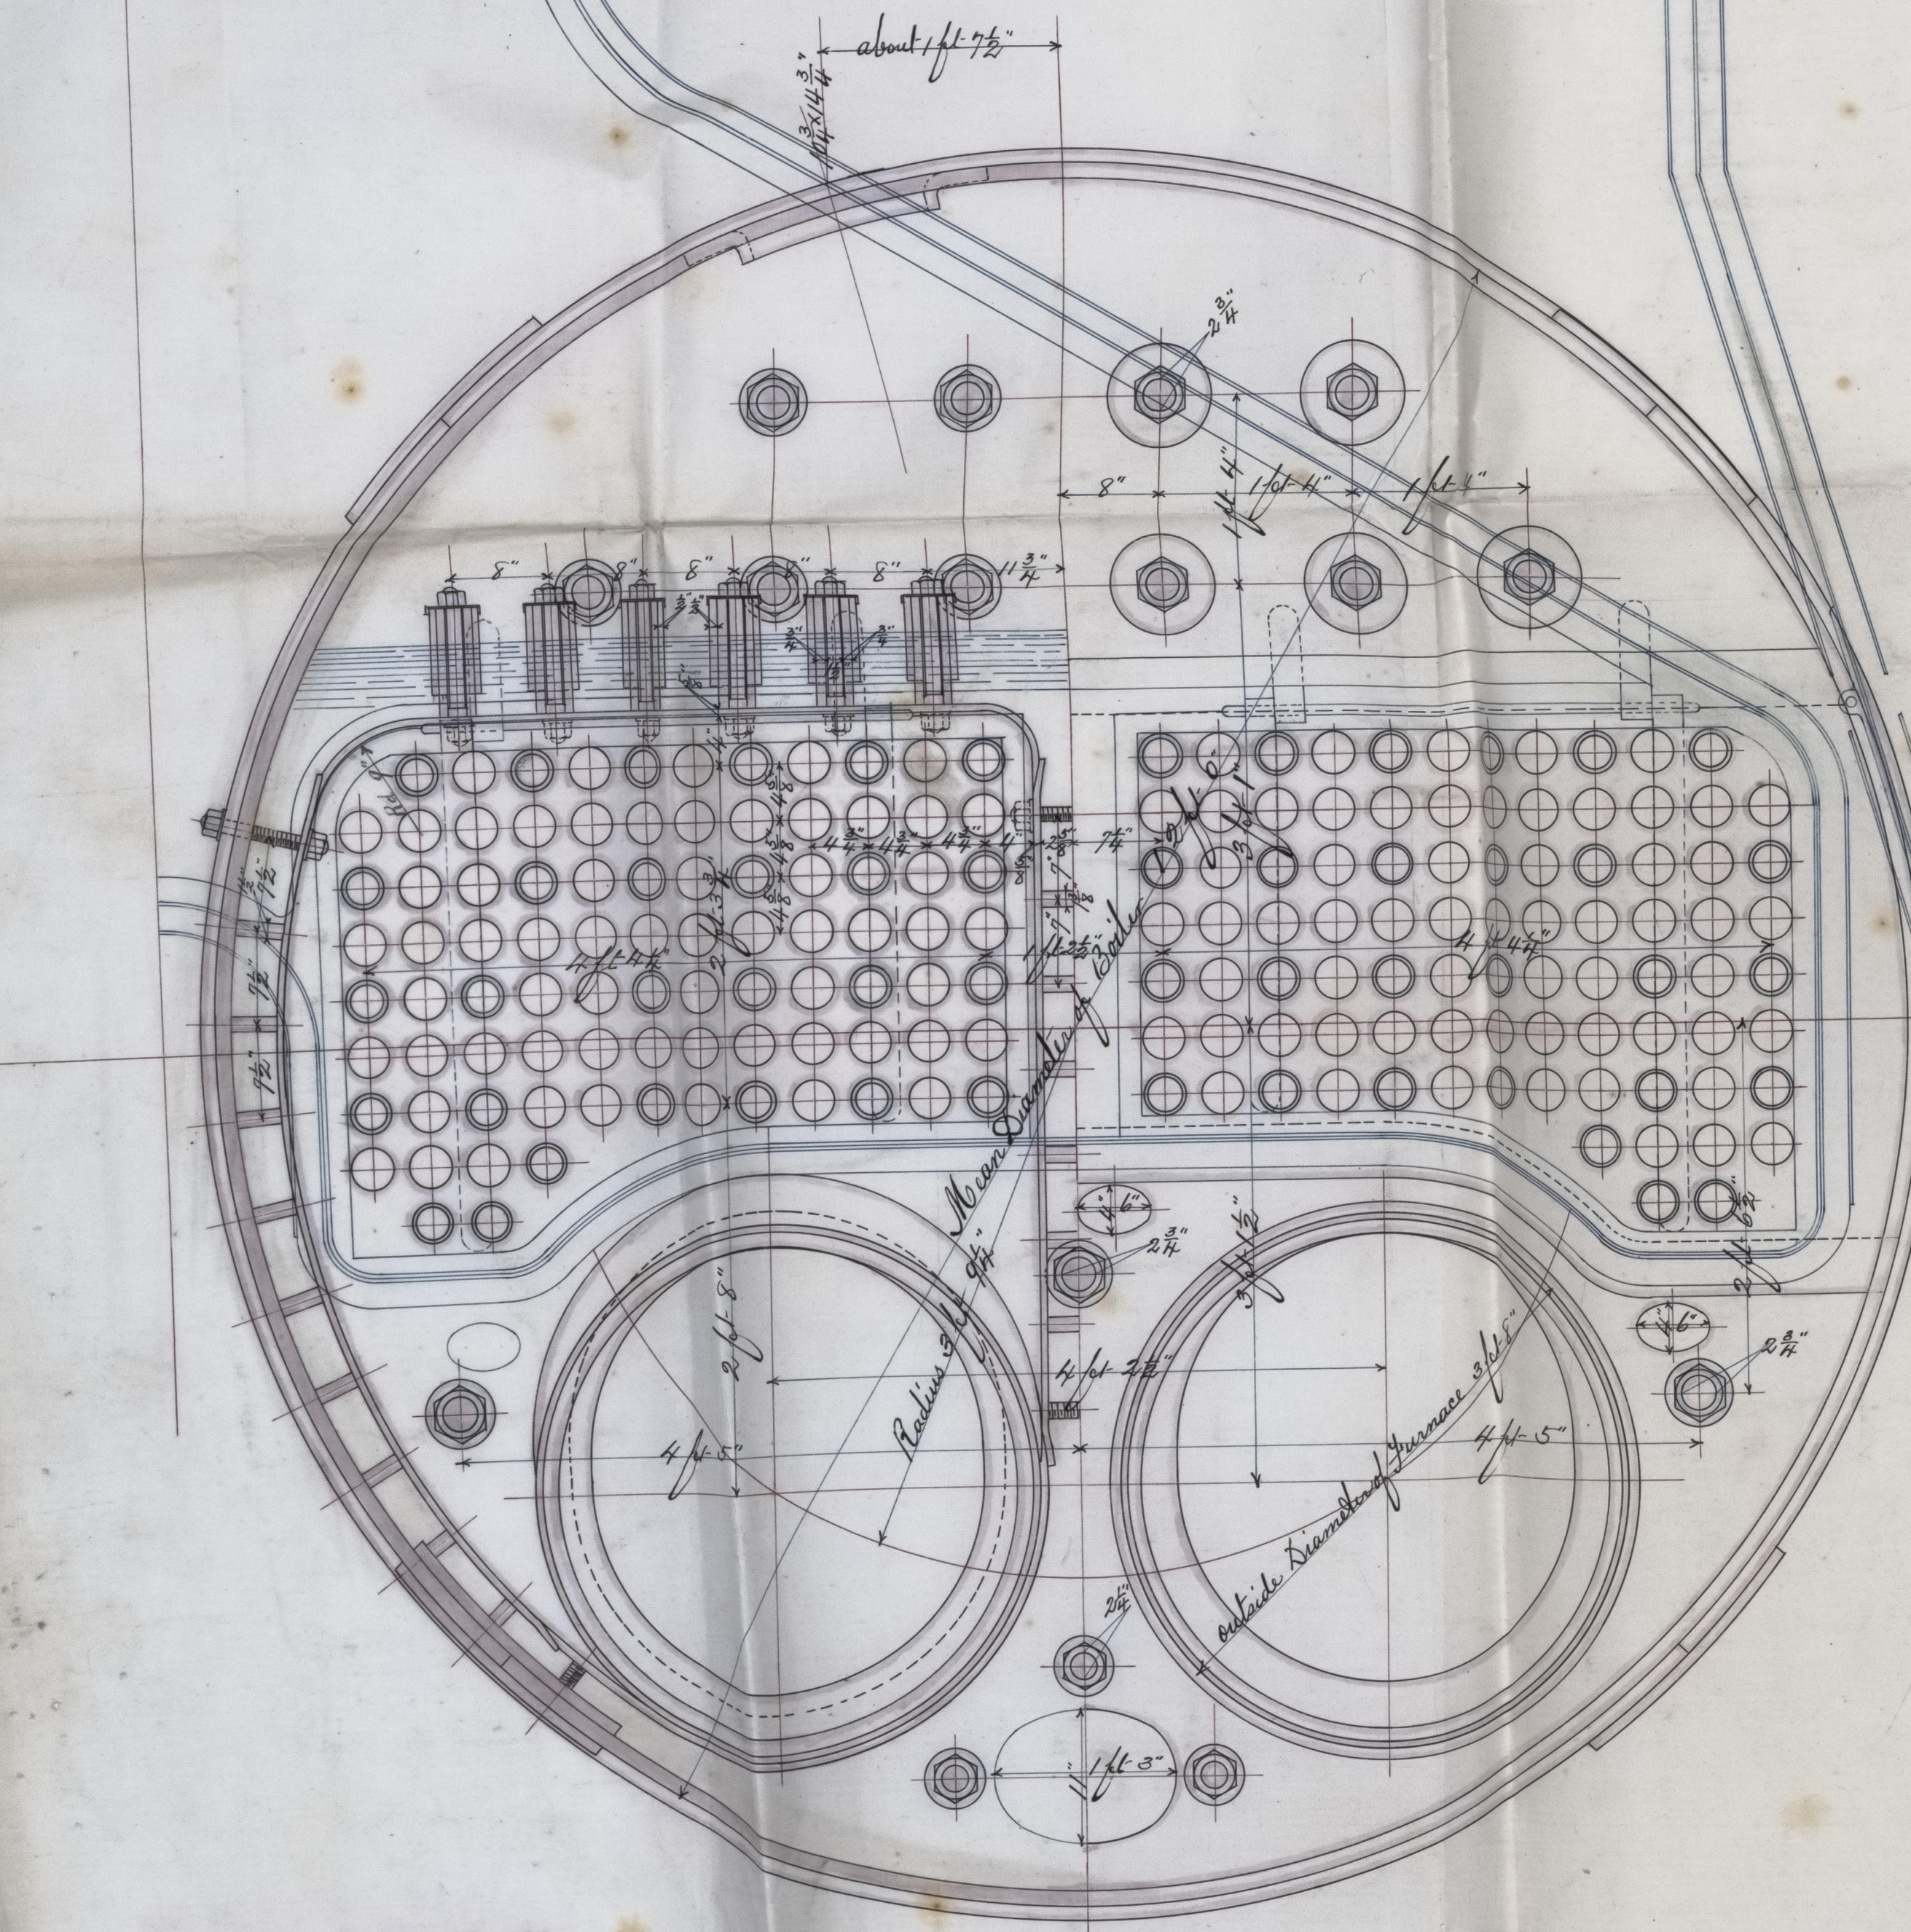

Sharata

MITSU-BISHI
DOCKYARD & ENGINE WORKS
NAGASAKI

Drawn by _____
Traced by *Y. Yamada*
Checked by *H. Yamada*
Date *16-2-97*



LOYD'S REGISTER OF SHIPPING
RECEIVED
14 APR. 1897
LONDON

BOILERS

FR

ENGINE

THE FOOT

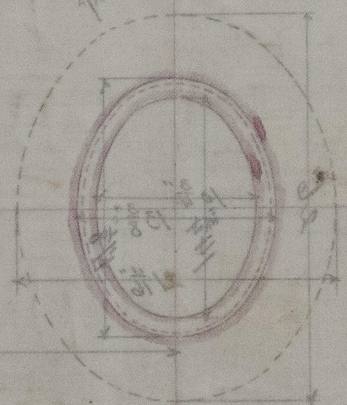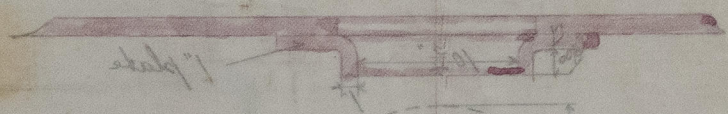

2 1/2"



© 2021

Lloyd's Register
Foundation