


S. S. Blythewood

note - not to scale

NEWPORT REPORTS N^o 8926 & 8933

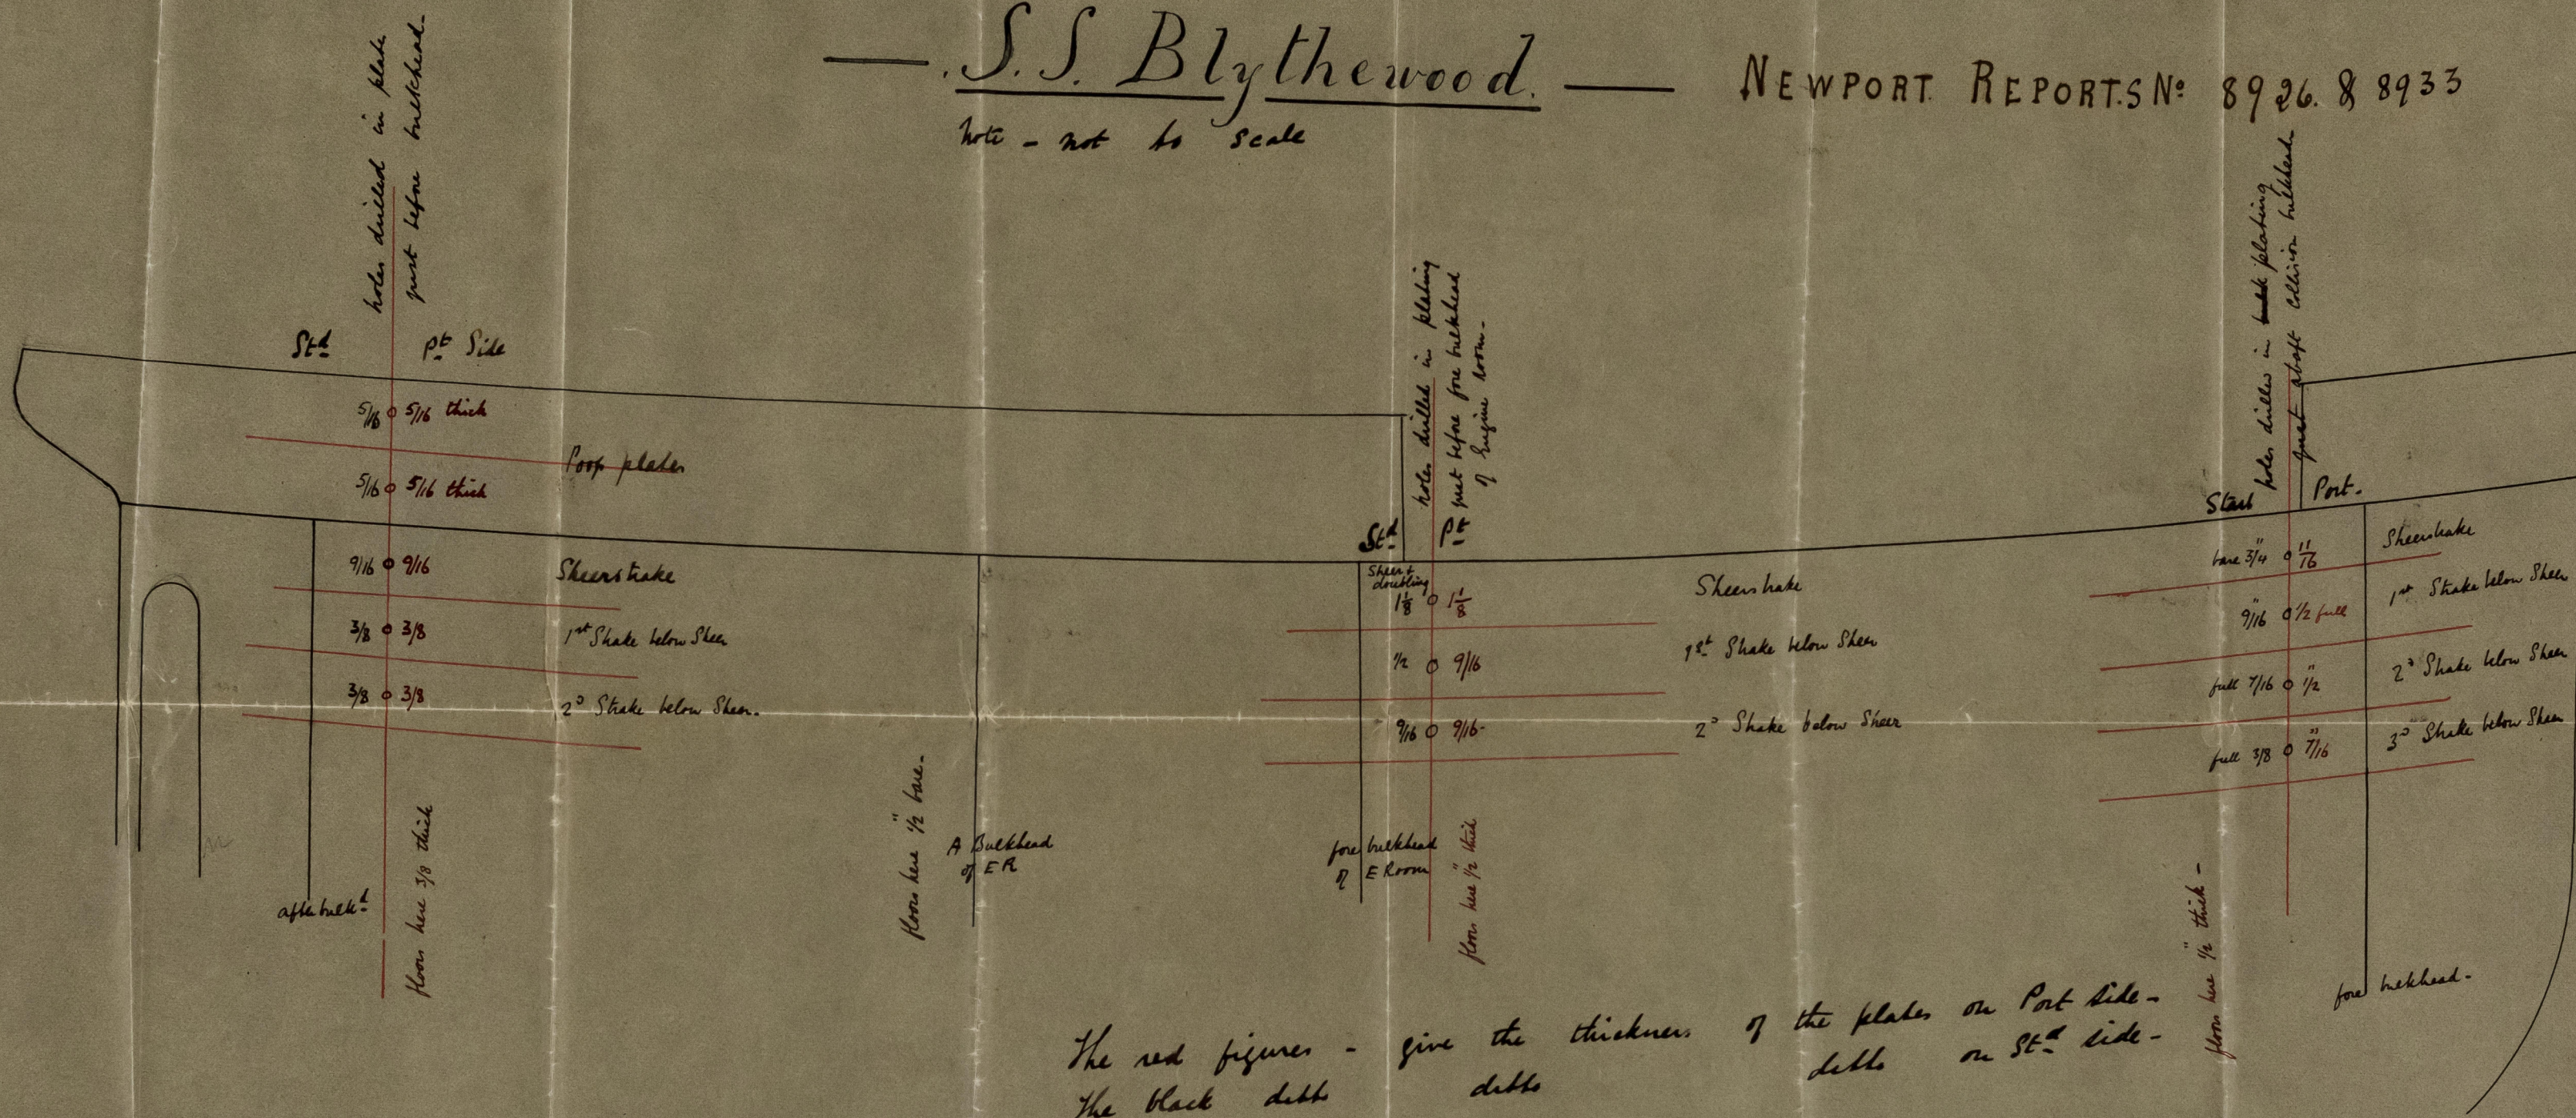

The red figures - give the thickness of the plates on Port Side -
 The black dots dots on St. Side -

Sketch showing where plating was drilled
 & thickness found.