

## IRON OR STEEL SHIP.

(Received at London Office)

18

No. 183

Survey held at

Date of writing Report

Port of

Last Survey

Rig

Master

Year of appointment

Built at

When built

Launched

By whom built

Owners

Managers

(If desired to be entered in Reg. Book.)

Residence

Port belonging to

Destined Voyage

If Surveyed while Building, Afloat, or in Dry Dock.

TONNAGE under

Tonnage Deck

Do. between Tonnage Dk. and 3rd, 4th, Spar or Awning Dk.

Tonnage under Upper Dk.

of Poop

of Raised Qr.

Dk. or Break

of Bridge House

of Houses on Deck

of excess of Hatchways

of Forecastle

is Tonnage

Crew Space

Engine Room

ter Tonnage

out on Beam

ONE, OR TWO DECKED, THREE DECKED VESSEL, SPAR, OR AWNING-DECKED VESSEL.

Half Breadth (moulded)

Depth from upper part of Keel to top of Upper Deck Beams

Girth of Half Midship Frame (as per Rule)

1st Number

1st Number, if a 3-Decked Vessel deduct 7 feet

Length

2nd Number

Proportions—Breadths to Length

Depths to Length—Upper Deck to Keel

Main Deck ditto

LENGTH Feet. Inches. BREADTH—Feet. Inches. DEPTH top of Floors to Upper Deck Beams Feet. Inches. Do. do. Main Deck Beams

Dimensions of Ship per Register, length, 91.9 breadth, 18.0 depth, 7.2

KEEL, depth and thickness

IRON-POST for Rudder do. do.

" " for Propeller

Distance of Frames from moulding edge to

moulding edge, all fore and aft

BEAMS, Angle Iron, for 1/2 length amidships

Do. for 1/4 at each end

REVERSED FRAMES, Angle Iron

FLOORS, depth and thickness of Floor Plate

at mid line for half length amidships

thickness at the ends of vessel

depth at 1/4 the half-bdth. as per Rule

height extended at the Bilges

BEAMS, Upper, Spar, or Awning Deck

Angle or d'ble Ang. Iron, Plate or Tee Bulb Iron

Angle or double Angle Iron on Upper edge

Average space

BEAMS, Main, or Middle Deck

Angle or d'ble Ang. Iron, Plate or Tee Bulb Iron

Angle, or double Angle Iron, on Upper Edge

Average space

BEAMS, Lower Deck

Angle or d'ble Ang. Iron, Plate or Tee Bulb Iron

Angle or double Angle Iron on Upper Edge

Average space

BEAMS, Hold, or Orlop

Angle or d'ble Ang. Iron, Plate or Tee Bulb Iron

Angle or double Angle Iron on Upper Edge

Average space

KEELSONS Centre line, single or double plate,

box, or Intercoastal, Plates

Rider Plate

Bulb Plate to Intercoastal Keelson

Angle Irons

Double Angle Iron Side Keelson

Side Intercoastal Plate

do. Angle Irons

Attached to outside plating with angle iron

LGE Angle Irons

do. Bulb Iron

do. Intercoastal plates riveted to

plating for length

LGE STRINGER Angle Irons

Intercoastal plates riveted to plating for length

DE STRINGER Angle Irons

FRAMES extend in one length from

REVERSED ANGLE IRONS on floors and frames extend

KEELSONS. Are the various lengths of Plates and Angle Irons properly connected?

PLATING. Garboard, double riveted to Keel, with rivets

Edges of Garboards and to upper part of Bilge, worked clench, double riveted; with rivets

Butts from Keel to turn of Bilge, worked earvel, double riveted; with rivets

Butts of Strakes at Bilge for length, treble riveted with Butt Straps

Edges from Bilge to Main Sheerstrake, worked clench, double or single riveted; with rivets

Butts from Bilge to Main Sheerstrake, worked earvel, double riveted; with rivets

Edges of Main Sheerstrake, double or single riveted.

Butts of Main Sheerstrake, treble riveted for length amidships.

Butts of Main Stringer Plate, treble riveted for length amidships.

Breadth of laps of plating in double riveting

Butt Straps of Keelsons, Stringer and Tie Plates, treble, double or single Riveted?

What description of Iron is used for Frames, Beams, Keelsons, Tie, and Stringer Plates, Outside Plating, &amp;c.?

Manufacturer's name or trade mark,

The above is a correct description.

Builder's Signature,

Surveyor's Signature,

Surveyor to Lloyd's Register of British and Foreign Shipping



Do the edges of the carvel work and of the butts lay close together throughout their length without requiring any making good of deficiencies? No  
Are the fillings between the ribs and plates solid single pieces? Yes Do the holes for riveting plate to frames, butt straps, or plate  
to plate, &c., conform well to each other? Yes Are the rivet holes well and sufficiently countersunk in the plate and punched  
from the faying surfaces? Yes Do any rivets break into or through the seams or butts of the plating? No

Masts, Bowsprit, Yards, &c., are wood in good condition, and sufficient in size and length. If of Iron or Steel give Scantlings of Plating, Angle Irons, &c., and further explain by a Sketch showing how the lower Masts and Bowsprit are constructed, showing the number of Plates and Angle Irons, mode of riveting, quality of Materials, and if stumped with Maker's name.

State also Length and Diameter of Lower Masts and Bowsprit

none fore mast 50' length 14" diameter. Main mast 40' length 12" diameter.

Number for Equipment		CABLES, &c.			Test per Certificate.	Fathoms & Inches per Rule.	Machine where Tested and Superintendent, also Name of Chain Maker.	ANCHORS.		Weight.	Test per Certificate	W'ght req'd per Rule.	Machine where Tested and Superintendent, also Name of Anchor Maker.
Letter for do.		Number of Certificate.	Fathoms.	Inches.	Tons.			Number of Certificate (State if any and which Anchors are Stockless.)	Ex. Stock.				
N.	SAILS.												
0	Fore Sails,	<del>1</del> 12/16	75	13/16		120					1	3 1/2	
0	Fore Top Sails,	25	190	11/16		116					1		
1	Fore Topmast Stay Sails,	48	90	10/16									
	Iron Stream Cabin or Steel Wire .. )					45	8/16						
1	Main Sails,	Hempen Str'm Cabl						Collective Weights				7	
0	Main Top Sails, and quality	TOWLINE—Hemp or Steel Wire	120			75	5 1/2	Stream 2.....	441 <sup>p</sup> 220	1	0.3.0		
	Hawser		100			94.3"		Kedge .....	332 <sup>p</sup>	1	0-2-0		
	Warp.....							2nd Kedge....	134 <sup>p</sup>				

The Windlass is good. Capstan none and Rudder good Pumps good

**Engine Room Skylights.**—How constructed? *in plain wood* How secured in ordinary weather? *in hinges*

What arrangements for deadlights in bad weather? - low scuttles in each hold

**Coal Bunker Openings.**—How constructed? *each side of bulkers* How are lids secured? *hinged-bolts* Height above deck? *none*

**Scuppers, &c.**—What arrangements for clearing upper deck of water, in case of shipping a sea? *Five scuppers each side and three*

**Cargo Hatchways.**—How formed? *iron* **Hatches, If strong and efficient?** *yes*

State size **Main Hatch** 20 + 8 Forehatch none Quarterhatch none

If of extraordinary size, state (how framed and secured... ) What arrangement for shifting beams ?

Order for Special Survey No. ys ngc 00 1st. On the several parts of the frame, when in

Date .....

Order for Ordinary Survey No. ....

3rd. When the beams were in and fastened, }  
and before the decks were laid }


Date \_\_\_\_\_

No.	in builder's yard.	Date held as in	5th. After the ship was launched and equipped	Total No. of Visits
1				
2				
State dates of letters respecting this case

General Remarks (State quality of workmanship, &c.) *General conditions sufficiently good for the*


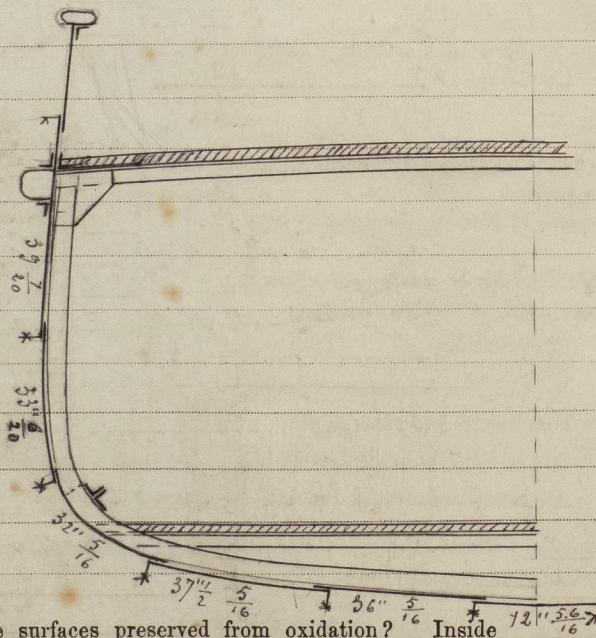

How are the surfaces preserved from oxidation? Inside  $12 \frac{11}{16}$  Outside

Particulars for Record in R.B.—Length of Poop ..... ft., R.Q.D. .... ft, Bridge Dk., ..... ft., F'castle ..... ft.; No. of Dks. (excluding spar, awn., &c.) .....

Material of dks. .... If spar, awn. dk., &c. .... Material of spar, awn. dk., &c. .... ; No. of tiers of beams (with and without dks. laid) .....

Official No. \_\_\_\_\_; Signal Letters \_\_\_\_\_.

I am of opinion this Vessel should be Classed 73 A

The amount of the Entry Fee .....£ 7 : : to be received by me, *if crossed*

Special .....£ 18 : :

(to be sent as per margin). Certificate ... : L : O  
(Travelling Expenses, if any, £ ... )  
FBI 2 JAN 81

Committee's Minute

Character assigned Deferret FRI 16 JAN 91

Received

Write to the Surveyor in

compare with Memphis 22

Remarks (Ref) Inquire

